


Section 18 Township 34 Range 24 W

Well No. # 1 C. C. Theis

Company I. W. Siegel et al

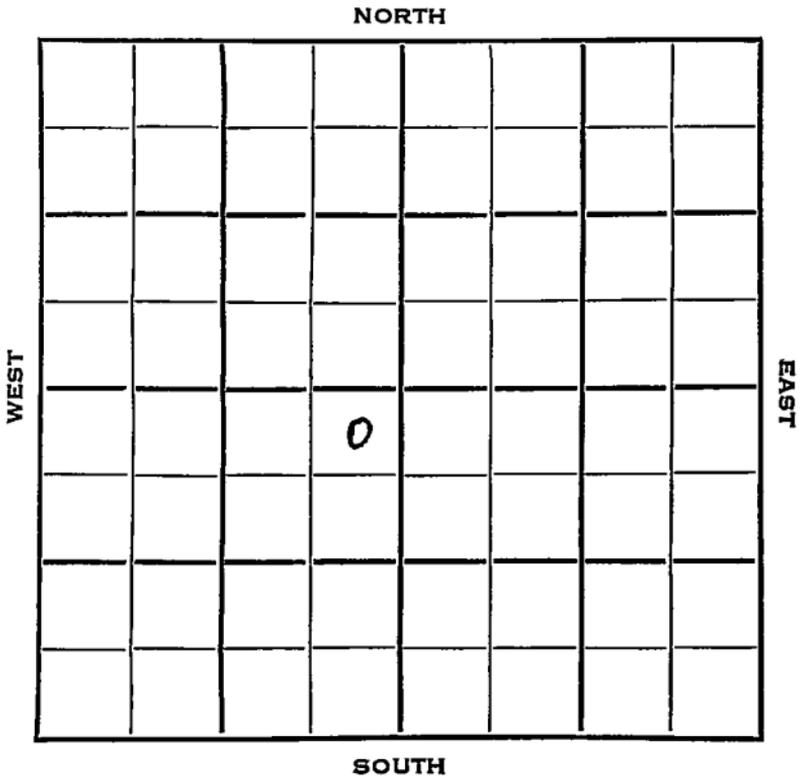

Sec. 18 Twp. 34 R. 24W

Well No. #1 G. C. Theis Farm

I. W. Siegel et al Company

Geo. Vye Contractor


Wildcat

330 Ft. from N. Line

330 Ft. from S. Line

330 Ft. from E. Line

NE NE SW Ft. from W. Line

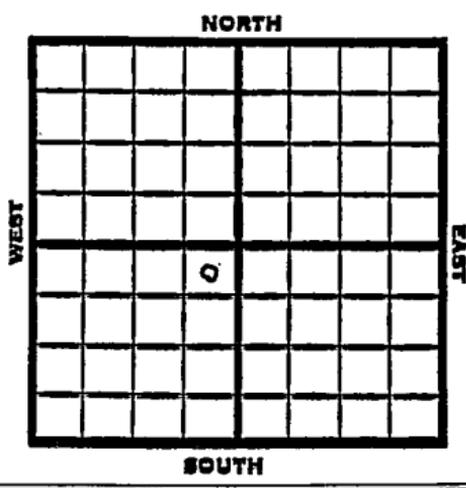

1953

Elev. 2002' **REPORT**

4/29 Spud 4-26-53  
10" @ 600, WOC

5/7 Win 2335  
Drlg. 3285'

5/21 DST 4789-4821 1 hr, 2610' SW 1650#  
Cherokee 5122'  
Drlg 5275'

5/28 NR

- 6/4 Schlumberger Tops:
- Top Lansing.....4459
  - Top Marmington.....5113
  - Top Cherokee.....5302
  - Top Morrow.....5539
  - Top Chester.....5547
  - T. D.....5830
  - 5 1/2" casing set....5753
  - Perforated 42 Holes...5546-60
  - " 18 " 5602-08
  - " 18 " 5612-18
  - " 30 " 5642-52
  - " 48 " 5666-84

Set packer at 5656' 1000 acid tested  
4,400,000 Plus 1 bbls oil, 4000 acid and  
8000 acid 30,000,000 gas decreased to  
13,000,000 gas, est 10,000,000 gas well

**OVER** (McGhee)

~~1953~~

~~6/14~~ ~~HEEB~~ ~~Elec. Miss 4354~~ ~~WRONG CARD~~  
~~Woe. Miss. 4359~~  
~~Solid Miss. 4577~~  
~~RTD 4507~~ Elec log - D & A (Letter)

1953

6/10 No report

6/24 NR

7/2 Completed for 9,700,000 cu. ft. of gas  
(Letter-McGehee)

7/1

Spud 4-26-53

Gas Well

TD 5830'

10" @ 600'

Win 2335, Heeb 4305

DST 4789-4821 opn 1 hr, rec 2610' sw  
1650#

DST 5570-5626 opn 1 hr, 20 min,  
rec 30' mud. 710#

TD 5830'

5" @ 5753'

42/ 5546-60 18/ 5602-08 18/ 5612-18

30/ 5642-52 48/ 5666-84 SP 5656

1000 A 4,400,000 gas 1 bo 4000 A

8000 A 30 mcfg dec. to 13 mcfg

Schlumberger Tops: Lans 4459, Marm

5113, Cherokee 5302, Morrow 5539,

Chester 5547

Comp. 9,700,000 gas.

**COMPLETED**



MAY 1 1953

|                |    |
|----------------|----|
| Scout Cards    | AD |
| Land Small Map |    |
| Land Wall Map  | B  |
| Tracings       |    |
| France Map     |    |
| Pierce Map     |    |
| Misc.          |    |



JUL 6 1955

Scout Card *SP*

Land Small Map *SP*

Land Map

Findings

France Map

1955

Dir: [illegible]