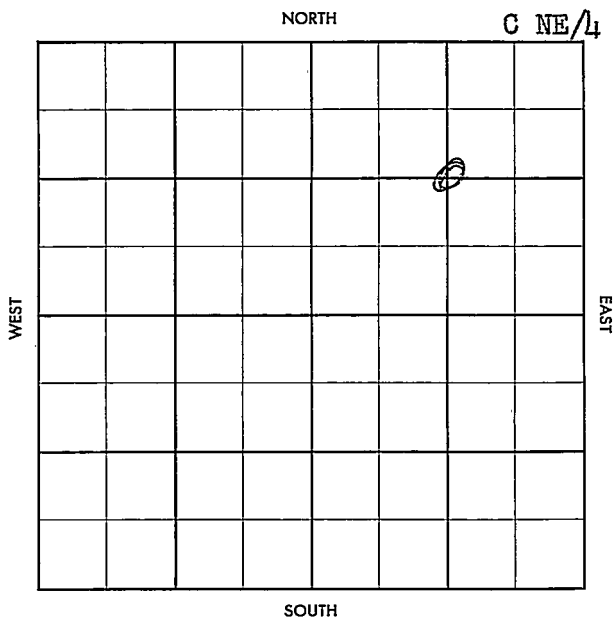


Clark

KANSAS

SECTION 18 TOWNSHIP 34 RANGE 25WWELL NO. #1 R. Dorsey G.U.COMPANY Atlantic-Texhoma-Skelly & Magnolia

County Clark Elev. _____
 Sec. 18 Twp. 34 Rge. 25W
 Company Atlantic-Texhoma-Skelley & Magnolia
 Farm Name R. Dorsey G. U. No. 1

TOPS	DEPTH	LOG	DATUM	Loc. in Sec.
Anb.				C NE/4
T.P.				
H.				
Tr.				
Dg.				
Bl.				
L.				Geol. _____
K.C.				
B.K.C.				Contr. _____
Ce.				
C.				Roy Langford
M.				
M.				Pool _____
K.				McKinney
Mz.				
Me.				
V.				
S.				
S.				
A.				
R.				
Pe.				
G.				
T.D.				

AUG 14 '57

FIRST REPORT

Date Comm. 8-10-57
8" @ 1213/600, WOC

24

County Clark Elev. 2095
 Sec. 18 Twp. 34 Rge. 25W
 Company Atlantic-Texhoma-Skelly & Magnolia
 Farm Name R. Dorsey G. U. No. 1

TOPS	DEPTH	LOG	DATUM	Loc. in Sec.
Anh.				C NE/4
TP.				
H.	4300			
Tr.				
Dg.				
BL.				
L.	4502	4505		Geol.
K.C.				Contr.
B.K.C.				
C.	U MW 5609	5616		Roy Langford
M.	5668	5644		Pool
M.				McKinney
K.				
Mz.				
Mo.				
V.				
S.				
S.				
A.				
R.				
PE.				
G.				ABANDONED
TD.	5875			

Date Comm. 8-10-57

8" @ 1213/600, WOG

AUG 21 '57

AUG 28 '57

SEP 4 '57 DST 5611-78 40" 60'
 SGCM FP 45-45 BHP 140/20
 DST 5677-5738 30" 20' MD
 FP 10-28 BHP 20 DST 5734
 5840 SEP 11 '57 op 30" rec 10' MD

BHP 15 BBH 15/15"

FP 15-15 RTD 5875

Log L 4505 Man 5616

M 5644 D + a