


KANSAS
KANSAS

Stevens

Section 18 Township 34 Range 35WWell No. 1 AndersonCompany Cities Service Gas

Hugoton Pool

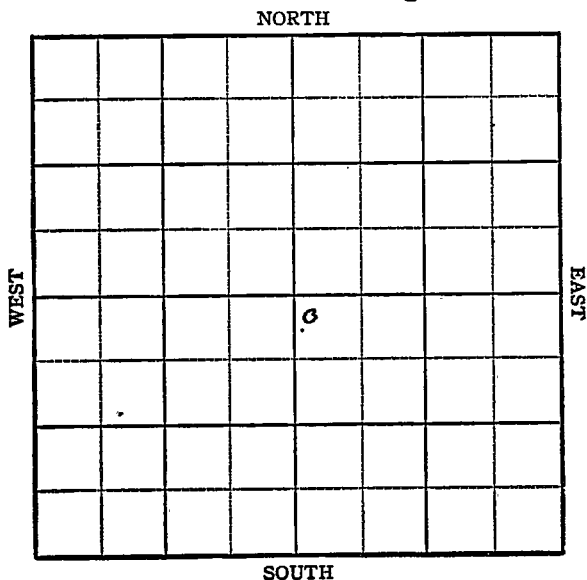

KANSAS

Stevens

Sec. 18 Twp. 34 R. 35W

Well No. #1 Anderson Farm

Cities Service Gas Company

Hugoton


150' Ft. from N. Line

_____ Ft. from S. Line

_____ Ft. from E. Line

150' Ft. from W. Line

NW SE

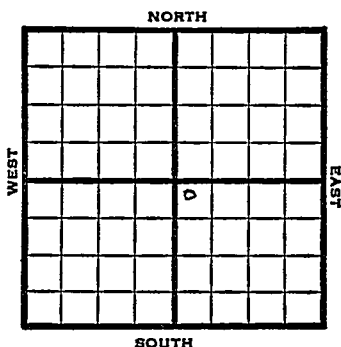

1948

Elev 3031' REPORT

12/8

RUR

12/14

10" @ 716'

TD 2670'

7 @ 2664'

12/22

TD 2760

2000 acid

12/29

TD 2808'

168' of 5" Perf liner at 2808

15,000 acid

1949

1/12

TD 2808'

7"@ 2664'

168' of 5" Perf Liner @ 2808'

21000 acid

22,019,000 Gas

409# R Pr.

Comp

COMPLETED

Map No. _____ Sec. 18 Twp. 34 R. 35W

Well No. 1 Anderson

_____ Cities Service Gas _____ Company

_____ ~~FIRST REPORT~~ _____ Contractor

NW SE


SECTION PLAT

150 Ft. from N. Line

_____ Ft. from S. Line

_____ Ft. from E. Line

150 Ft. from W. Line

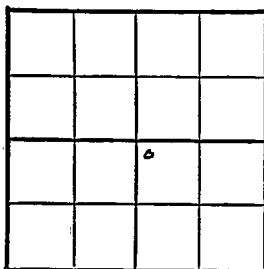

Stevens County

Location _____

Rig up _____

Drilling and Remarks: _____

R U R

RECORD

Cased _____ in., _____ ft.

Sand _____

Gas _____

Oil _____

Total Depth _____

PRODUCTION

1st 24 hrs. Nat. _____

1st 24 hrs. after shot _____

Gas _____ Cu. Ft.

Dry Hole _____

Abandoned _____

Date

DEC 8 1948₁₉

S. J. LEWIS Scout

Map No. _____ Sec. 18 Twp. 34 R. 35W

Well No. 1 Anderson

Cities Service Gas _____ Company

COMPLETE _____ Contractor

NW SE


E. 3431
SECTION PLAT

150 Ft. from N. Line

_____ Ft. from S. Line

_____ Ft. from E. Line

150 Ft. from W. Line

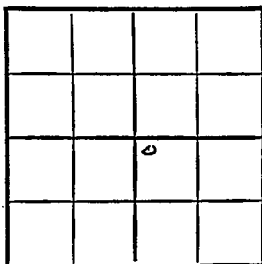

Stevens County

RECORD

Location _____

Rig up _____

Drilling and Remarks:

Cased _____ in., _____ ft.

Sand _____

Gas _____

Oil _____

Total Depth 2805

7" @ 2664

168 7/8" Perf. liner
@ 2805

21000000

22,019,000 Bar

409 * R/P

PRODUCTION

1st 24 hrs. Nat. _____

1st 24 hrs. after shot _____

Gas _____ Cu. Ft.

Dry Hole _____

Abandoned _____

Date

JAN 12 1949 19

S. J. LEWIS Scout