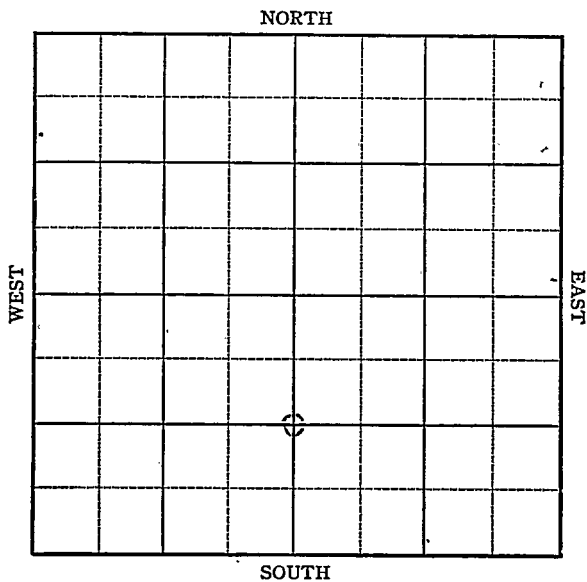


KANSAS

Stevens county

Section 18 Township 34 Range 37-WWell No. #1, SpanglerCompany Panhandle Eastern

KANSAS

Stevens ✓


Sec. 18 Twp. 34 R. 37WWell No. #1 Spangler FarmPanhandle Eastern Company

Hugoton

Ft. from N. Line

1320 Ft. from S. Line2640 Ft. from E. Line

Ft. from W. Line

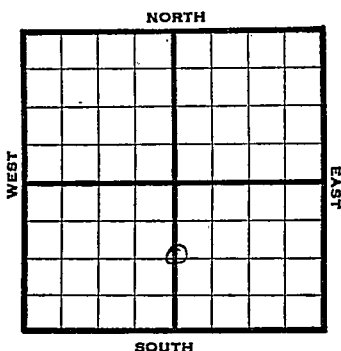C S $\frac{1}{2}$ Sec.

1946 Elev. 3178

REPORT

10/16	Drlg 500'		
10/22	10" @ 617'		
	7" @ 2625'		
	TD 2740', RUST		
10/29	TD 2857'		
11/6	"		
11/12	250' of 5" Perf liner @ 2857'		
11/20	"	"	"
11/27	"	"	"
12/3	"	"	"
12/10	"	"	"
12/17	"	"	"
1947			
1/2	205' of 5" Perf liner @ 2857'		
1/8	"	"	"
1/15	"	"	"
1/21	14000 Acid		

COMPLETED

1/29 TD 2857'
7" @ 2625
250' of 5" Perf liner @ 2857
14000 Acid
26,618,000 Gas
372#R Pr

Map No. _____ Sec. 18 Twp. 34 R. 37WWell No. 1 Spangler

Panhandle Eastern


Company

FIRST REPORT

Contractor

C S $\frac{1}{2}$ Sec.

SECTION PLAT

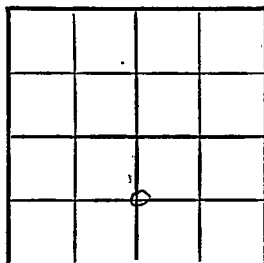

_____ Ft. from N. Line

1320 Ft. from S. Line2640 Ft. from E. Line

_____ Ft. from W. Line

Stevens County

Location _____

Rig up _____

Drilling and Remarks:

drlg. 500'

RECORD

Cased _____ in., _____ ft.

Sand _____

Gas _____

Oil _____

Total Depth _____

PRODUCTION

1st 24 hrs. Nat. _____

1st 24 hrs. after shot _____

Gas _____ Cu. Ft.

Dry Hole _____

Abandoned _____

Date

OCT 16 1946 19

S. J. LEWIS

Scout

Misc. Small Maps

Cards *Sarah*

Tracing ☒

France Map ☒

Scarborough Map ☒

Pierce Map ☒

Geological Dept. ☐

Pierce Plat Book ☐

Map No. _____ Sec. 18 Twp. 34 R. 37W

Well No. 1 Spangler

Panhandle Eastern Company

COMPLETE

Contractor

C $S\frac{1}{2}$ Sec.


E 13178
SECTION PLAT

_____ Ft. from N. Line

1320 Ft. from S. Line

2640 Ft. from E. Line

_____ Ft. from W. Line

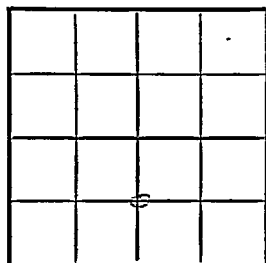

Stevens County

Location _____

Rig up _____

Drilling and Remarks: _____

7" C 2625
250 7/8" Pig line
C 2757
14000 rods
26, 618,000 Gas
272" R M

RECORD

Cased _____ in, _____ ft.

Sand _____

Gas _____

Oil _____

Total Depth 2857

PRODUCTION

1st 24 hrs. Nat. _____

1st 24 hrs. after shot _____

Gas _____ Cu. Ft.

Dry Hole _____

Abandoned _____

Date

JAN 29 1947 19

S. J. LEWIS Scout

Misc. Scrap ☒
 Cards ☒
 Trading ☒
 France Map ☒
 Scarborough Map ☒
 Pierce Map ☒
 Geological Dept. ☒
 Pierce Plat Book ☐

6122