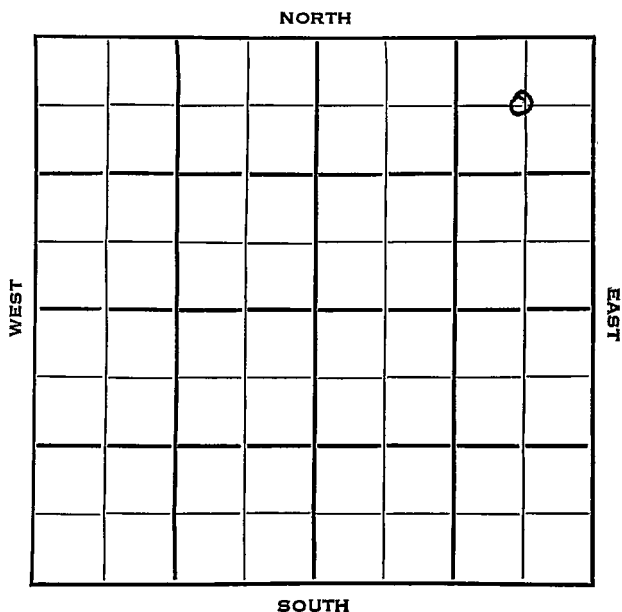


Section 18 Township 34 Range 43WWell No. 1 GovernmentCompany Huber Corp.

Morton KANSAS

SEC.	TWP.	R.
18	34	43W
WELL NO.		
1 Government		FARM
COMPANY		
Huber Corp.		
CONTRACTOR		


S. Greenwood Pool

660 Ft. from N. Line

Ft. from S. Line

660 Ft. from E. Line

Ft. from W. Line

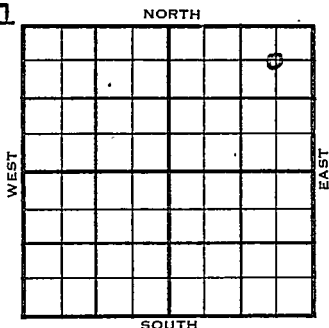

C NE NE

	ELEVATION	REPORT
1954	3620'	
2/10	MIR	4850' Test
2/17	9" @ 520' w/300 sks Drlg 2270'	4395' 3620' 775'
2/24	Drlg 3240'	
5/19	Spud 2-11-54 Gas Well. TD 4670' 9" @ 520' DST 2757'-80' opn 1½ hr, rec 100,000 gas, 100' gcm, 465# Top. 2810' DST 2897'-3020' opn 3/4 hr, rec 100,000 gas, 140' gcm, 485# DST 3050'-3126' opn 3/4 hr, 70,000 gas 130' gcm, 500# DST 3167'-3240' opn 1 hr, rec 140' sgcm 465# DST 4561'-84' opn 1 hr, rec 100' Mud TD 4665' KC 3050', Cherokee 3820', Morrow 4395' DST 4602'-70' opn 1 hr, rec 105' vsgcm 0# TD 3670' TD 4670'	3620' 2810' 810'

OVER


1954

Information brought forward.

5/19 DST 4403'-13' opn $1\frac{1}{4}$ hr, rec 170' Mud
1175#
5" @ 4503'
60/ 3435-55 1000 A SP 3320
60/ 3206-26 36/ 3245-57 1000 A
SP 3186'
36/ 3112-24 18/ 3130-36 . 20 bswph
SP 3085'
42/ 3064-78 $7\frac{1}{2}$ bswph SP 3030'
30/ 2998'-3008' 18/ 2986'-92' 18/
2972'-78' 6 bswph CO to 2990
39/ 2963-76 24/ 2953-61 4 bswph
PB 2942
30/ 2930-40 21/ 2919-26 $\frac{1}{2}$ mcfg.
PB 2900'
45/ 2863-78 1000 A 530,000 gas
7 bswph Miss 4594'
PB 2850'
21/ 2807-14 CO to 2850
63/ 2807'-28' 24/ 2778'-86'
15/ 2767'-72' 2754-61 500 M-A
 $1\frac{1}{2}$ bsw. 50,000 gas 4000 A $1\frac{1}{2}$ mcfg.
5 bsw.
5000 A 2,130,000 gas.
Comp 2,130,000 cfigpd.

COMPLETED

County Morton State Kansas
 Sec. 18 (Blk.) 34 (Sur.) 43W Map No.
 Operator Huber Corp.
 Well No. 1 Farm Government
 Elev. _____ Location C NE NE

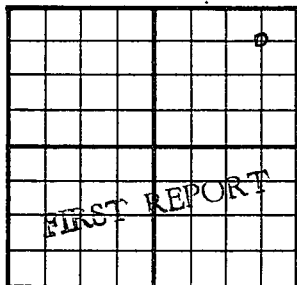

660 Ft. From N Line NE
660 Ft. From E Line Quarter
 1st. Report FEB 10 1954

Completion _____

Remarks 4850' test

Spudding Date _____

Drlg. Data _____

S. Greenwood pool

M I R


J. G. McGEHEE

FEB 11 1954

Scout Cards	45
Land Small Map	
Land Wall Map	
Tracings	3
France Map	
Pierce Map	
Map	
Map	

Orig. Data

County Morton State Kansas
 Sec. 18 (Blk.) 34 (Sur.) 43W Map No.
 Operator Huber Corp.
 Well No. 1 Farm Government
 Elev. 3620 Location C NE NE

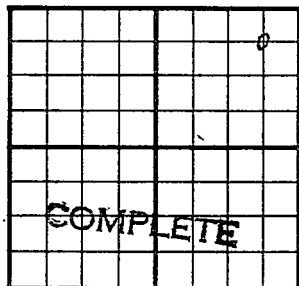

660 Ft. From N Line NE
660 Ft. From E Line Quarter

1st. Report

Completion MAY 1 1954

Remarks S. Greenwood Pool

Spudding Date 2-11-54

Drlg. Data Gas well TD 4670

9" @ -520 DST 2757-80 open 1½ hr.

Rec. 100,000 gas 100' gcm 465#

Top. 2810 DST 2897-3020 open ¾ hr.

Rec. 100,000 gas 140' gcm 485#

DST 3050-3126 open ¾ hr. 70,000 gas

130' gcm 500# DST 3167-3240 open 1 hr.

Rec. 140' sgcm 465# DST 4561-84

open 1 hr. Rec. 100' mud TD 4665

KC 3050 Cherokee 3820 Morrow 4395

DST 4602-70 open 1 hr. Rec. 105' vs gcm

0# TD 4670 DST 4403-13 open 1½ hr.

Rec. 170' mud 1175# 5" @ 4503

60/ 3435-55 1000 A SP 3320 60/ 3206-

26 36/ 3245-57 1000 A SP 3186

J. G. McGEHEE

Orig. Date

36/ 3112-24 18/ 3150-36 20 bswph

SP 3085 42/ 3064-78 20 bswph SP 3030

30/ 2998-3008 18/ 2986-92 18/ 2972-78

6 bswph 30/ 2998-3008 18/ 2986-92 18/ 2972-78

24/ 2953-61 4 bswph 30/ 2930-2942

40 21/ 2919-26 2 bswph 30/ 2900

45/ 2863-78 1000 A 530,000 Gas

7 bswph 21/ 2807-14 PB 2850 4594

CO to 2850 63/ 2807-28 24/ 2778-86

15/ 2767-72 2754-61 500 M-A 1 1/2 bsw

50,000 Gas 4000 A - 1 1/2 mcf 5 bsw

5000 A 2,130,000 Gas

Comp. 2,130,000 cfpd