


Map No. KANSAS Sec. 18 Twp. 34 R. 39^w
Well No. 1-Dixon Farm 17
Argus Gas Company

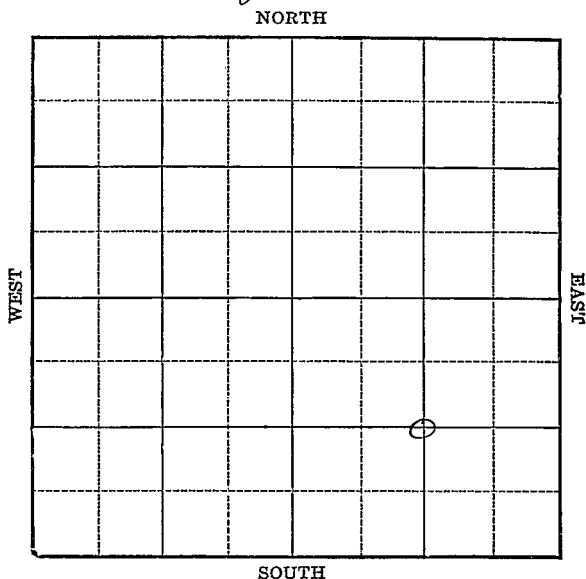

Location _____
Drilling Remarks _____

Rig Up _____
Drilling Remarks _____

RECORD


Cased _____ in. _____ ft.
Sand _____
Gas _____
Oil _____
Total Depth _____

PRODUCTION

1st 24 hrs. Nat. _____
1st 24 hrs. after shot _____
Gas _____ cu. ft. _____
Dry Hole _____
Abandoned _____

Map No. KANSAS Sec. 18 Twp. 34 R. 39^w
Well No. 1- Dixon Farm
Argue Gas Company

NORTH

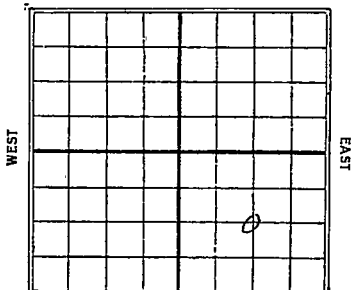

Ft. from N. Line

1320 Ft. from S. Line

1320 Ft. from E. Line

Ft. from W. Line

SOUTH

Date

REPORT

4/23	Loc.
4/30	Rigging up.
5/7	Rel. 500'
5/14	" 2000'
5/21	" 2515
5/28	2545-8" Rust
6/4	
6/11	Rel. 2740'
6/18	Card 2545-2900
	10 2900
	shot 60 qt
	4 ft gas
	Comp


Morton
Map No. **KANSAS** Sec. *18* Twp. *34* R. *39W*

Well No. *1 Dixon*

Regis Gas. Company

Contractor

SECTION PLAT

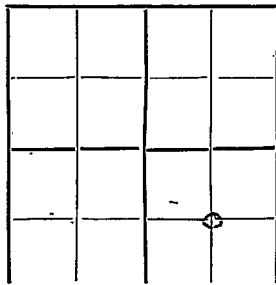

_____ Ft. from N. Line

1320 Ft. from S. Line

1320 Ft. from E. Line

_____ Ft. from W. Line

FIRST REPORTS

Location *✓*

Rig up

Drilling and Remarks:

RECORD

Cased _____ in., _____ ft.

Sand _____

Gas _____

Oil _____

Total Depth _____

PRODUCTION

1st 24 hrs. Nat. _____

1st 24 hrs. after shot _____

Gas _____ Cu. Ft.

Dry Hole _____

Abandoned _____

Date

_____ 192_____

S. J. LEWIS Scout


*Worton.*Map No. **KANSAS** Sec. *18* Twp. *34* R. *29 W*Well No. *1 Dixon**Argus Gas.* Company*J* Contractor

SECTION PLAT

Ft. from N. Line

1820 Ft. from S. Line*1820* Ft. from E. Line

Ft. from W. Line

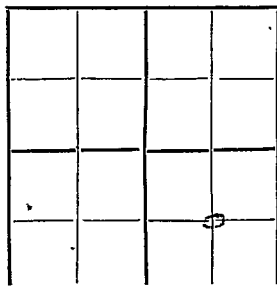

COMPLETED

Location

Rig up

Drilling and Remarks:

*shot 60 gts.**401 Gas*

RECORD

Cased _____ in., _____ ft.

Sand *2545-2900*

Gas _____

Oil _____

Total Depth *2900*

PRODUCTION

1st 24 hrs. Nat. _____

1st 24 hrs. after shot _____

Gas _____ Cu. Ft.

Dry Hole _____

Abandoned _____

Date

*JUN 18 1930**S. J. LEWIS* Scout