

Meade


KANSAS

SECTION 19 TOWNSHIP 34 RANGE 29W

WELL NO. #1 H.G. Adams Ranch

COMPANY Carl B. Anderson (Okla. City)

NORTH

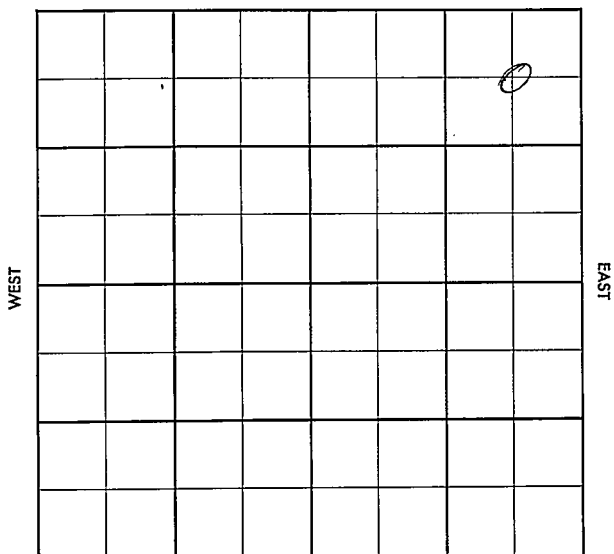

SOUTH

County Meade Elev. _____
 Sec. 19 Twp. 31S Rge. 29W
 Company Carl B. Anderson (Okla. City)
 Farm Name H. G. Adams Ranch No. 1

TOPS	DEPTH	LOG	DATUM	Loc. in Sec. _____
Anh.				<u>Gen NE NE</u>
TP.				
H.				
Tr.				
Dg.				
Bl.				
L.				Geol. _____
K.C.				Contr. _____
B.K.C.				
Ce.				<u>An-Son</u>
C.				
M.				Pool _____
M.				<u>Wildcat</u>
K.				
Mz.				
Mo.				
V.				
S.				
S.				
A.				
R.				
Pe.				
G.				
T.D.				

Date Comm. _____

ITD

FIRST REPORT
 OCT 3 '56

Co.

Lse.

No.

Sec.

T.

R.

CORRECTION

FORM 513 SUNRAY

County Moade Elev. 2542
 Sec. 19 Twp. 34S Rge. 29W
 Company Carl B. Anderson (Okla. City) Texas
 Farm Name H. G. Adams Ranch No. 1

TOPS	DEPTH	LOG	DATUM	Loc. in Sec.
Anb.				Gen NE NE
Tp.				
H.	4394			
Tr.	4440			
Dg.				
BL.				
L.	4555			
K.C.	19 arm 5240			Geol.
B.K.C.				Contr.
Ce.	MW ? 5780			An-Son
C.	" sd 5840-5910			Pool <u>1756</u>
M.	chester 5910	5916		Wildcat
M.				
K.				
Mz.				
Me.				
V.				
S.				
S.				
A.				
R.				
Pe.				
G.				
TD.	6050			

COMPLETE

DEC 5 '56

Date Comm. TEX SUPP.

ITD OCT 10 '56 9-26-56 8578 1664

1700 3420 4671

OCT 24 '56 5318 OCT 31 '56 5791

- 5828 1 hr 20' Md (556)

FP 30-40 BHP 75'-20" DST

5838-5916 1 hr 100' Md

BHP 1270/20" W.O.O. NOV 7 '56

5 1/2 @ 6050 NOV 13 '56 CO 5986 32/

5892-5900 & dry Frac Fluid

Flw 9 2 B Load oil / PH + 2 Mil
 CFC pd. 24 / 5880-86 40 /
 5865-75 32 / 5847-55 PH
 PFS 5892-5900 Fric ga

1.980 MCFG pd + Ld oil NOV 21 '56

Flwd 1.900 MCFG + Ld 8' wt

Flwd 1.309 MCFG + Ld 8' wt

S.I. NOV 28 '56 DEC 5 '56 20" B.D. ga.

4.227 MCFG SIP 1440 #