


Section 19 Township 34 Range 33-W

Well No. #1 Gleeson "A"

Company Cities Service

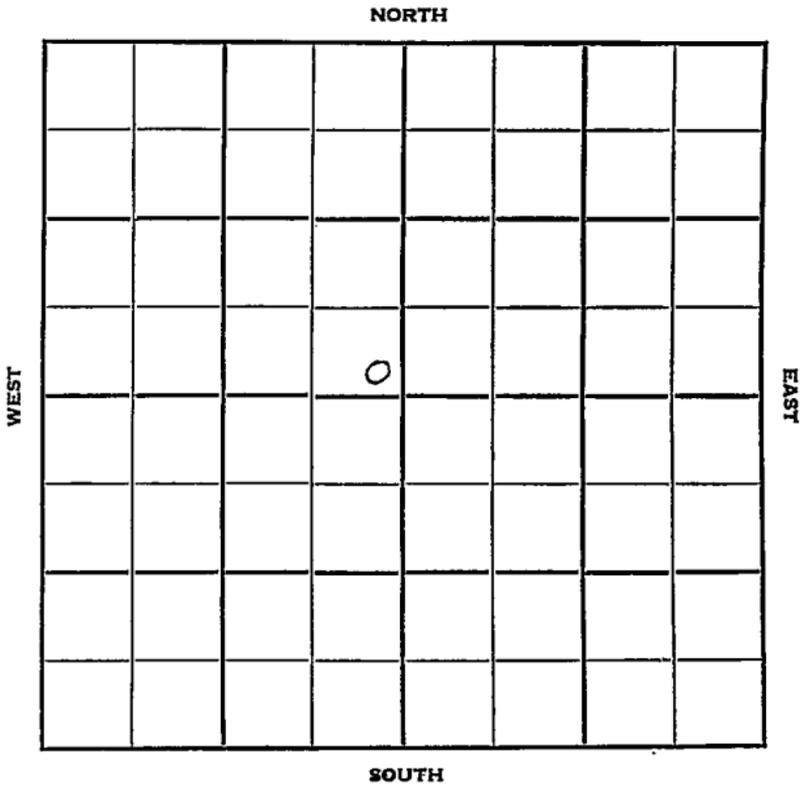

Sec. 19 Twp. 34 R. 33-W

Well No. #1 Gleeson "A" Farm

Cities Service

Company

Barbour

Contractor

Hugoton


\_\_\_\_\_ Ft. from N. Line

150 Ft. from S. Line

150 Ft. from E. Line

\_\_\_\_\_ Ft. from W. Line

SE NW

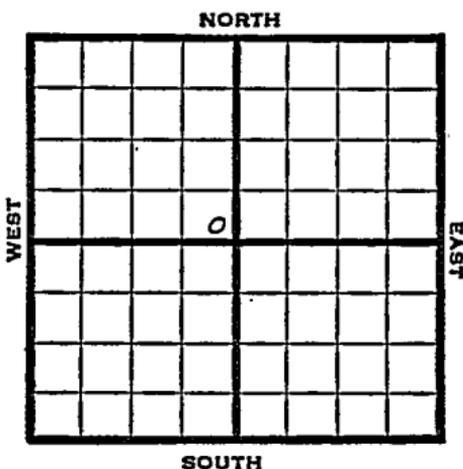

1950

Elev. 2883 REPORT

10/11 Location

1951

1/3 Spud 10-10-50  
 Gas Well TD 2770  
 8-5/8" @ 720 TD 2770  
 5" @ 2769  
 Her. 2587 Krider 2621 Win. 2706  
 CO to 2743 80/2706-22 3000 A  
 PB 2700 140/2652-80 70/2616-30  
 40/2596-2604 20/2588-92 8000 A  
 4500 A Comp. 15,100,000 427 #

**COMPLETED**




County Seward State Kansas

Sec. 19 (Blk.) 34 (Sur.) 33W Map No.

Operator Cities Service

Well No. 1 Farm Gleeson "A"

Elev. 2883 Location SE NW

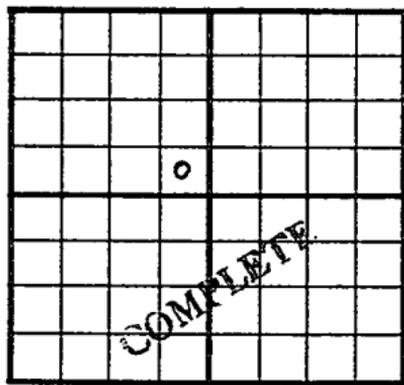

150 Ft. From S Line NW

150 Ft. From E Line Quarter

1st. Report

Completion JAN 3 1951

Remarks Hugoton Pool

Barbour - Contr.

Spudding Date 10-10-50

Drig. Data Gas well TD 2770

8 5/8" C 720 TD 2770 5" C 2769

Her. 2587 Krider 2621 Win. 2706

CO to 2743 80/ 2706-22 3000 A PB 2700

140/ 2652-80 70/ 2616-30 40/ 2596-2604

20/ 2588-92 8000 A 4500 A

Comp. 15,100,000 gas 427#