

KANSAS


Seward

Section 19 Township 34 Range 34-WWell No. #2 RogersCompany Plains Natural

NORTH

WEST

EAST

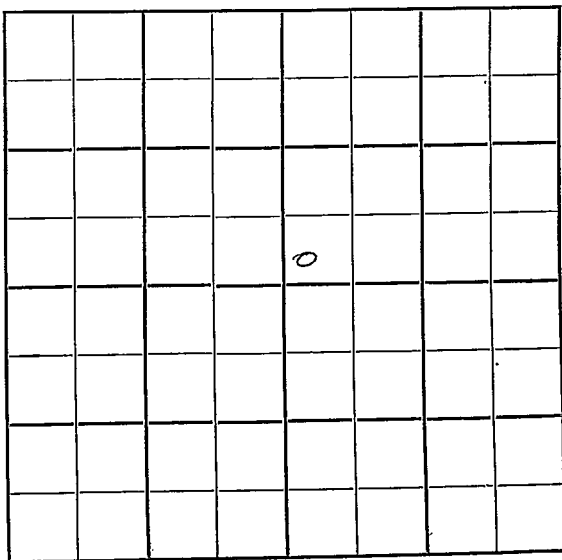

SOUTH

Seward

KANSAS

Sec. 19 Twp. 34 R. 34W

Well No. #2 Rogers Farm

Plains Natural Company

Contractor

Hugoton Pool


Ft. from N. Line

200' Ft. from S. Line

Ft. from E. Line

200' Ft. from W. Line

SW NE

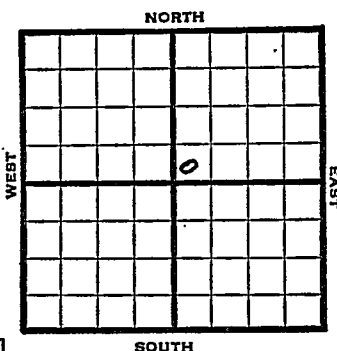

Gas Well

1950 Elev 2953 REPORT

8/16 Location

10/11 10" @ 711

7" @ 2759

TD 2764

30/2727-32, 180/2692-2722, 48/2664-72

48/2638-46, 30/2630-35, 30/2752-57

30/2745-50

Hol 2573

Her 2630

Krider 2663

Win 2744

16000 total acid

Comp 2,755,000 gas

Del. test 428#

Completed

COMPLETED



Sec. **19** (Blk. **34** (Sur. **347** Map No.

Well No. 2 Farm Rogers

Elev. 2953 Location SW NE

0

FIRST REPORT

200 Ft. From S Line NE

200 Ft. From ~~E~~ Line Quarter

1st. Report AUG 16 1950

Completion

Remarks


Spudding Date

Drlg. Data Hugoton Pool

Location

J. E. TYRA

County Seward State Kansas
 Sec. 19 (Blk. 34) (Sur. 34W) Map No. 34W
 Operator Plains Natural Gas
 Well No. 2 Farm Rogers
 Elev. 2953 Location SW NE

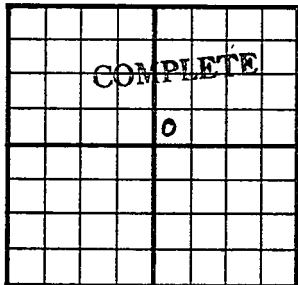

200 Ft. From S Line NE
200 Ft. From W Line Quarter

Ist. Report

Completion OCT 11 1950

Remarks Hugoton Pool

Spudding Date

Drlg. Data Gas well TD 2764

10" @ 711 7" @ 2759 TD 2764

30/ 2727-32 180/ 2692-2722 48/ 2664-72

48/ 2638-46 30/ 2630-35 30/ 2752-57

30/ 2745-50 Hol. 2573 Her. 2630

Krider 2663 Win. 2744 16000 total acid

Comp. 2,755,000 gas Del. test 428#

J. E. TYRA