

FORM 51


Morton


KANSAS

Section 19 Township 34 Range 43W

Well No. #1 Interstate "A"

Company Cities Service Oil Company

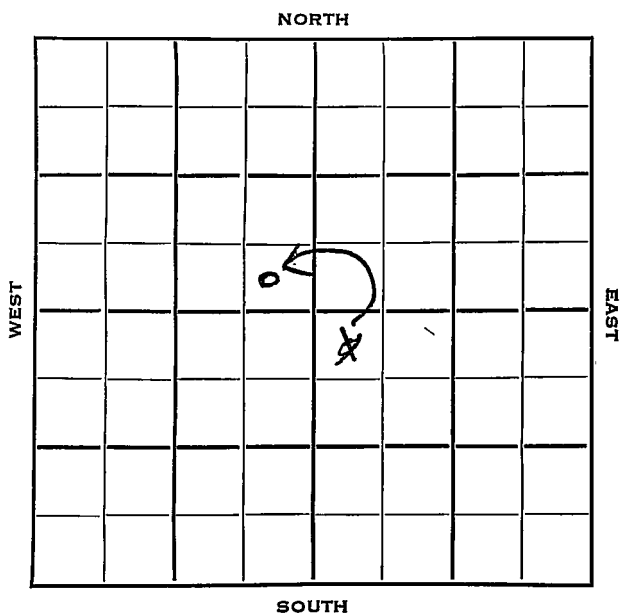

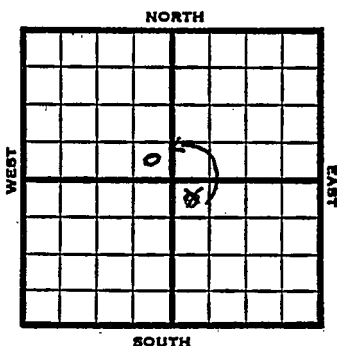Sec. 19 Twp. 34 R. 43 WWell No. # 1 Interstate "A" FarmCities Service Oil CompanyRine Drlg. Contractor~~330~~ Ft. from N. Line330 Ft. from S. Line330 Ft. from E. Line330 Ft. from W. Line~~SE SE NW~~
~~NW NW SE~~

1953

Elev. 3509' REPORT

Miss. Test

3/25

Location

4/2

18" @ 95'

13" @ 604'

4/9

DST 2734-97, 1 hr., gas in 9",
340,000 gas in 30", 80' GCM, 480#
DST

4/16

DST 3084-3115 1 Hr. 240' gcm
360' SW 465#
Drlg 4540'

4/23

RTD 4715

Schl 5" @ 4550'

Top 2698, Lans 2925.

4/30

N.R.

5/7

NR

5/21

"

5/28

NR

6/3

NR

6/10

NR

$$\begin{array}{r} 3509 \\ - 2698 \\ \hline 811 \end{array}$$

OVER

#1 Interstate "A"

1953

6/24

Spud 3-27-53

Gas Well

TD 4715

18" @ 95

13" @ 604

DST 2734-97, opn 1 hr., gas in 9 mins.,
340,000 gas, in 30 mins.

80' gcm, 480#

DST 3084-3115, opn 1 hr., rec. 240'
gcm, 360' sw, 465#

TD 4715

5" @ 4550

Top 2698, Lans 2925, Morrow sh 4100,
Chester 4620, St. Gen. 4660

100/4470-90, 2000A, 500 mud-acid

1000A, FU 3000' wtr. 14 hrs.

PB 4280 60/4238-50, 5 $\frac{1}{2}$ mcfg, 2000A
1500A

PB 4260, 2000A

Comp. 9,040,000 gas, 1145#

COMPLETED

3509	3509	4100	4620	4660
2698	2925	3509	3509	3509
+811	+584	-591	-1111	-1151

County **Morton** State **Kansas**

Sec. 19 (Blk.) 34 (Sur.) 43W Map No.

Operator **Cities Service Oil**

Well No. **1** Farm **Interstate "A"**

Elev.	Location	NW	NE	SE
-------	----------	----	----	----

FIRST REPORT

330 Ft. From N Line SE

330 Ft. From W Line Quarter

1st. Report MAR 25 1953

Completion

Remarks Miss. test

Rine Drlg. - Contr.

Spudding Date _____

Drlg. Data

J. G. McGEHEE

Scout Cards	mm
Land Detail Map	
Land Wall Map	GP
Tracings	
France Map	
France Map	
Misc.	

MAR 27 1953

Orig. Data

Kansas

Map No. _____ Sec. 19 Twp. 34 R. 43WWell No. 1 Interstate

Cities Service _____ Company

CORRECTION _____ Contractor

SE SE NW

SECTION PLAT

_____ Ft. from N. Line

330 Ft. from S. Line330 Ft. from E. Line

_____ Ft. from W. Line

Morton County

Location _____

Rig up _____

Drilling and Remarks:

Reported:

NW NW SE

RECORD

Cased _____ in., _____ ft.

Sand _____

Gas _____

Oil _____

Total Depth _____

PRODUCTION

1st 24 hrs. Nat. _____

1st 24 hrs. after shot _____

Gas _____ (Cu. Ft.)

Dry Hole _____

Abandoned _____

Date

APR 8 1953


19

J. G. McGEHEE Scout

APR 15 1953

Scout Cards	_____	AD
Land Small Map	_____	
Land Wall Map	_____	B
Tracings	_____	
France Map	_____	
Pierce Map	_____	
Misc.	_____	

County Morton State Kansas
 Sec. 19 (Blk.) 34 (Sur.) 43W Map No.
 Operator Cities Service Oil
 Well No. 1 Farm Interstate "A"
 Elev. 3509 Location SE SE NW

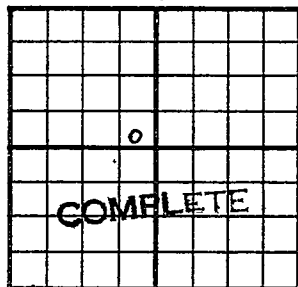

330 Ft. From S Line NW
330 Ft. From E Line Quarter
 1st. Report
 Completion JUN 24 1953
 Remarks
Rine Drlg. - Contr.
 Spudding Date 3-27-53

Drlg. Data Gas well TD 4715
18" @ 95 13" @ 604 DST 2734-97
open 1 hr. gas in 9 min. 340,000 gas
in 30 min. 80' gcm 480# DST 3084-3115
open 1 hr. Rec. 240' gcm 360' sw
465# TD 4715 5" @ 4550 Top. 2698
Lans. 2925 Morrow sh. 4100 Chester 4620
St. Gen. 4660 100/ 4470-90 2000 A
500 mud -acid 1000 A FU 3000' wtr.
14 hr. PB 4280 60/ 4238-50 5½ mcf/g
2000 A 1500 A PB 4260 2000 A
Comp. 9,040,000 gas 1145#

JUL 1 1953

Scout Cards	IP
Land Snail Map	
Land Wall Map	B
Tracings	
France Map	
Pierce Map	
Misc.	

Orig. Data