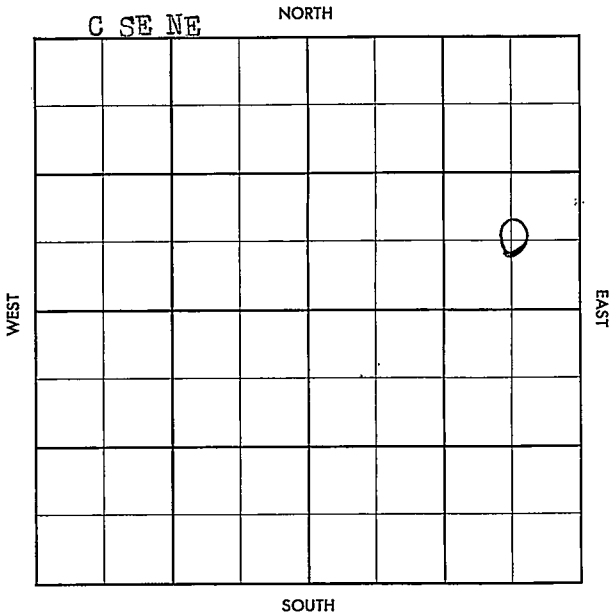


Morton

KANSAS

SECTION 19 TOWNSHIP 34 S RANGE 41 WWELL NO. # 0-2 TuckerCOMPANY Panhandle Eastern

County Morton

Elev. _____

Sec. 19Twp. 34Rge. 41WCompany Panhandle EasternFarm Name TuckerNo. 0-2

Co.

5

No.

Sec.

T.

R.

TOPS

DEPTH

LOG

DATUM

Loc. in Sec.

C SE NE

Anh.

Tp.

H.

Tr.

Dg.

Bl.

L.

K.C.

B.K.C.

Ce.

C.

M.

M.

K.

Mz.

Mq.

V.

S.

S.

A.

R.

P.E.

G.

T.D.

Geol. _____

Contr. _____

Garvey Tool

Pool

Taloga NE

FIRST REPORT

AUG 21 '57

Date Comm.

8-17-57

8" @ 1527/700, WOC

34

K 20

FORM 513 SUNRAY

County Morton Elev. 3461 DE
Sec. 19 Twp. 34 Rge. 41W
Company Panhandle Eastern
Farm Name Tucker No. 0-2

TOPS	DEPTH	LOG	DATUM	Loc. in Sec.
Anth.	608			C SE NE
Tp. W. L. H.	2796			
H. TP	3217			
Tr. Gr. L. H. S.	3297			
Dg. L. S.	3527			
Bl. C. S.	4292			
L. C. S. L. H. S.	4417			
K.C. M. M. S. H.	4615			Geol.
B.K. C. S. d.	4617-36			Contr.
Ce. S. d.	4965-73			Garvey Tool
C. G. S. d.	5062-91			Pool
M. D. L. C. Y. S.	5136-56			Taloga NE
M. L. K. C. Y. S.	5166-85			
K. M.	5201	-1740		
Mz.				
Me.				
V.				
S.				
S.				
A.				
R.				
PE.				
G.				
T.D.	5236			

COMPLETE
OCT 30 '57

Date Comm. 8-17-57

8" @ 1527/700, WOC AUG 25 '57 DP 3875

Rep. 119. SEP 4 '57 CR9 @ 2875

SEP 11 '57 end 4415-23 rec 6 1/2'

lim + s d end 4423-36 rec

11' lim chert s d DST 4398-

4436 2 hrs 140' S G CM FP 70-90

SH 295/20" end 4697-4723

rec 24' 18' shale 6' s d

end 4723-35 rec 11 1/2' 9 1/2' s d

2' 5d . DST 4719-35
 1 1/2 hrs G/35" TSTM 122 285"
 GCOI 2265 SO & GCSW
 140' 140 b GCM F-P 240-960
 1040/20" DST 4958-8/1 20"
 70' M1 F-P 0 BHP 560/20"
 5025 SEP 18 57 5064-5100 30"
 10' m F-P 0 BHP 890/20
 DST 5151-70 60" 120' m SW
 860 SW F-P 130-450 BHP
 1170/20" 5 1/2 4800 1300
 SEP 25 1957 20 4768 6/4720
 \$ 7 g o p h now frac 5x2
 \$ SQD OCT 2 57 CO 4750
 12/4718-21 \$ 27 g o p h now
 in time 100MA frac 4x1 1/2 \$
 145 BO 50 BSW 17 hrs
 P O P OCT 9 57 OCT 10 57 OCT 23 57 OCT 30 57
 PLY 46 BO 46 070 W
 24 hrs.

mon 4718-21