


Section 19 Township 34 Range 40 W

Well No. # 1 Murray "C"

Company Cities Service et al

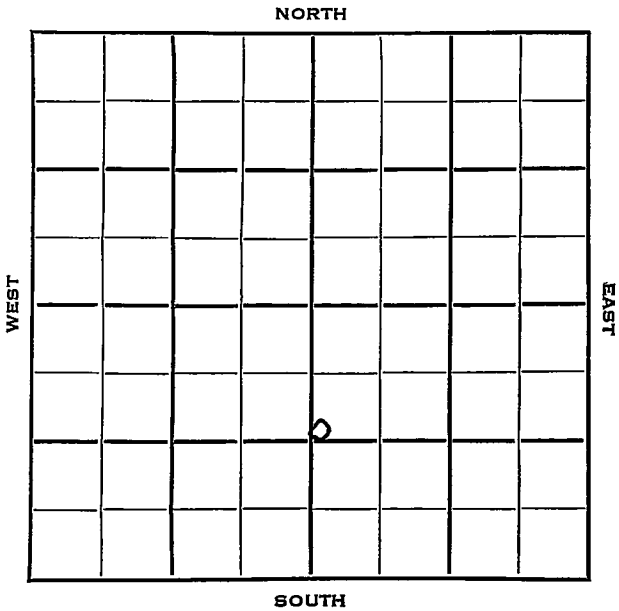

Morton
34

KANSAS
40W

Sec. 19 Twp. R.

Well No. #1 Murray "C" Farm

Cities Service et al Company

Hugoton Pool Contractor


1250 Ft. from N. Line

Ft. from S. Line

Ft. from E. Line

100 Ft. from W. Line

SW NW SE

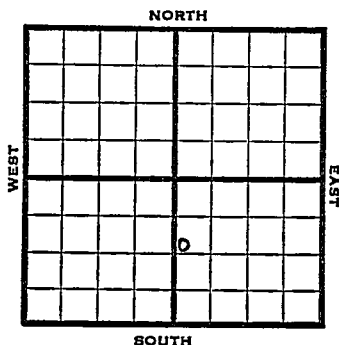

1953

Elev. 3398'

REPORT

4/29

Spud 4-23-53
8" @ 400
Drlg. 2195'

5/7

Her 2393, Up Kr 2414, Low Kr 2440
Win 2493
RTD 2555
5" @ 2550

5/21

CO 2534 70/ 2514-28 50/ 2494-2504
17,000 A

5/28

12,000A

6/3

Spud 4-23-53
Gas Well
TD 2555
8" @ 400
Her 2393, Kri 2414, Win 2493
TD 2555
5" @ 2550
CO to 2534
70/2514-28, 50/2494-2504 29000A
Comp. 7,010,000 gas, 399#

COMPLETED

County Morton State Kansas
 Sec. 19 (Blk. 34 (Sur. 40W Map No.
 (Twp.) (Rge.)
 Operator Cities Service etal.
 Well No. 1 Farm Murray "C"
 Elev. Location SW NW SE

1250 Ft. From N Line SE
100 Ft. From W Line Quarter

1st. Report APR 29 1953

Completion


Remarks

Spudding Date 4-23-53

Drlg. Data Hugoton Pool

8" @ 400 drlg. 2195

County Morton State Kansas
 Sec. 19 (Blk. 34 (Sur. 40W Map No.
 (Twp.) (Rge.)
 Operator Cities Service etal.
 Well No. 1 Farm Murray "C"
 Elev. 3398 Location SW NW SE

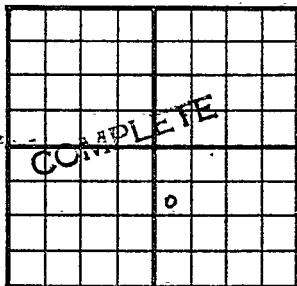

1250ft. From N Line SE
100ft. From W Line Quarter

1st. Report

Completion JUN 3 1953

Remarks Hugoton Pool

Spudding Date 4-23-53

Drig. Data. Gas well TD 2555

8" @ 400 Her. 2393 Kri. 2414

Win. 2493 TD 2555 5" @ 2550

CO to 2534 70/ 2514-28 50/ 2494-2504

29000 A Comp. 7,010,000 gas 399#