

REC'D 20 AUG 1988

SIDE ONE

STATE CORPORATION COMMISSION OF KANSAS
OIL & GAS CONSERVATION DIVISION
WELL COMPLETION OR RECOMPLETION FORM
ACO-1 WELL HISTORY
DESCRIPTION OF WELL AND LEASE

API NO. 15-191-22,068
County... Sumner
NE SW SE Sec. 17 Twp 34 S Rge 2 W West
990 Ft North from Southeast Corner of Section
1815' Ft West from Southeast Corner of Section
(Note: Locate well in section plat below)

Lease Name... Sparks Well # A-1
Field Name
Producing Formation
Elevation: Ground 1106' KB 1111'

Operator: License # 3667
Name Source Petroleum
Address 200 W. Douglas, Suite 820
City/State/Zip Wichita, KS 67202

Purchaser

Operator Contact Person John D. Howard, Jr.
Phone (316) 262-7397

Contractor: License # 5418
Name Allen Drilling Company

Wellsite Geologist Steve Davis
Phone 316-267-9115

Designate Type of Completion
 New Well Re-Entry Workover

Oil SWD Temp Abd
 Gas Inj Delayed Comp
 Dry Other (Core, Water Supply etc.)

If OWVO: old well info as follows:

Operator
Well Name
Comp. Date
Old Total Depth

WELL HISTORY

Drilling Method:

Mud Rotary Air Rotary Cable

7/16/88 7/28/88 7-28-88
Spud Date Date Reached TD Completion Date

4750' Total Depth PBTD


Amount of Surface Pipe Set and Cemented at 273 feet
Multiple Stage Cementing Collar Used? Yes No
If yes, show depth set...feet
If alternate 2 completion, cement circulated from...feet depth to...w/...SX cmt
Cement Company Name
Invoice #

RECEIVED
STATE CORPORATION COMMISSION

AUG 22 1988

COMPLETION DIVISION
Wichita, Kansas

Section Plat

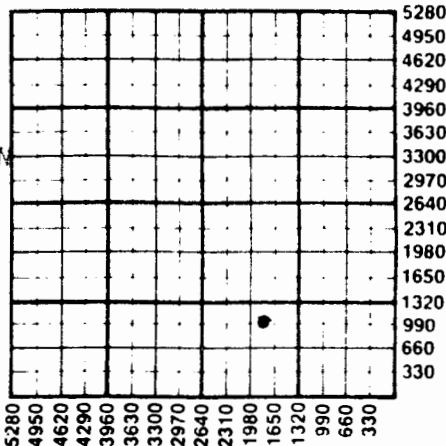

WATER SUPPLY INFORMATION

Disposition of Produced Water: Disposal
Docket # Repressuring

Questions on this portion of the ACO-1 call:
Water Resources Board (913) 296-3717

Source of Water:
Division of Water Resources Permit #

Groundwater...Ft North from Southeast Corner
(Well) ...Ft West from Southeast Corner
Sec Twp Rge East West

Surface Water...Ft North from Southeast Corner
(Stream, pond etc)...Ft West from Southeast Corner
Sec Twp Rge East West
1/2 mile South and 1 mile West of location.
Other (explain)
(purchased from city, R.W.D. #)

INSTRUCTIONS: This form shall be completed in triplicate and filed with the Kansas Corporation Commission, 200 Colorado Derby Building, Wichita, Kansas 67202, within 120 days of the spud date of any well. Rule 82-3-130, 82-3-107 and 82-3-106 apply.

Information on side two of this form will be held confidential for a period of 12 months if requested in writing and submitted with the form. See rule 82-3-107 for confidentiality in excess of 12 months. One copy of all wireline logs and drillers time log shall be attached with this form. Submit CP-4 form with all plugged wells. Submit CP-111 form with all temporarily abandoned wells.

All requirements of the statutes, rules and regulations promulgated to regulate the oil and gas industry have been fully complied with and the statements herein are complete and correct to the best of my knowledge.

Signature John D. Howard, Jr.
Title General Manager Date 8-19-88

Subscribed and sworn to before me this 19th day of August 1988
Notary Public Traci Grant
Date Commission Expires January 24, 1992

K.C.C. OFFICE USE ONLY
 Letter of Confidentiality Attached
 Wireline Log Received
 Drillers Timelog Received
Distribution
KCC SWD/Rep NGPA
 KGS Plug Other (Specify)

TRACI GRANT
State of Kansas
My Appt Exp. 11/24/92

AUG 25 1988
KANSAS GEOLOGICAL SURVEY
WICHITA BRANCH

Form ACO-1 (5-86)

Sec. 1 Twp. 34 Rge. 2 W