


Section 2 Township 34 Range ~~2E~~ 2W
Well No. 1 Mason
Company Thos. N. Berry et al

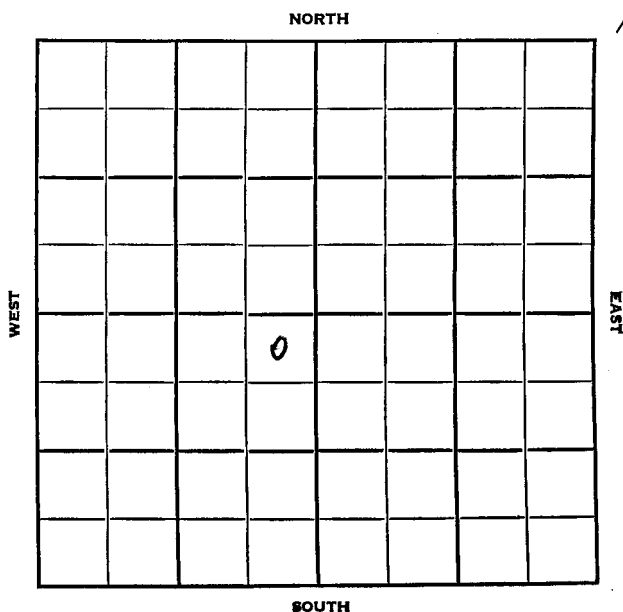

Sumner

KANSAS

SEC.	TWP.	R.
2	34	W 2 E

WELL NO.

1 Mason

FARM

COMPANY

Thos. N. Berry et al

CONTRACTOR

B & R Drlg.

Wildcat


330 Ft. from N. Line

Ft. from S. Line

330 Ft. from E. Line

Ft. from W. Line

NE NE SW

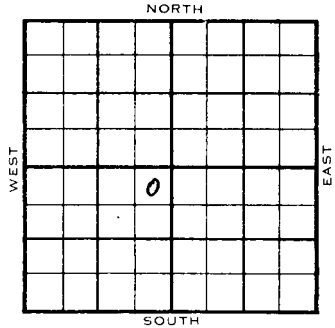


CSO - Acr.

	ELEVATION	REPORT
1954	1175'	
4/27	Spud 4-19-54 8" @ 161 Drlg. 2300'	
5/5	Stal 2939', Lay 3410', KC 3425' Drlg 3538'	
5/12	B KC 3620', Osw 3688', Miss 4048' Miss L. 4066' Drlg. 4145'	
5/19	Simp 4476' DST 4479'-90' 35", 70' M Simp sd 4496' DST 4499'-4509' 1 hr, 1960' SW	
5/26	Spud 4-19-54 D & A TD 4589 8" @ 161 Stal. 2939 Layton 3410 KC 3425 B KC 3620 Oswego 3688 Miss 4048 Miss. line 4066 Simp. 4476 DST 4479-90 open 35 min rec 70' mud Simp. sd. 4496 DST 4490-4509 open 1 hr rec 1960' SW TD 4589 D & A	
	ABANDONED	

Kansas

County _____ Summer _____ State _____
 Sec. 2 (Bk. Twp.) 34 (Sur. Rge.) 2W Map No. _____
 Operator Thos. N. Berry et al.
 Well No. 1 Farm Lason
 Elev. 1175 Location NE NE SW

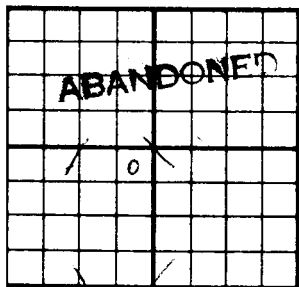

330 Ft. From N Line SW
 330 Ft. From E Line Quarter
 1st. Report _____
 Completion MAY 26 1954
 Remarks Wildcat
 B & R Drlg. - Contr.
 Spudding Date 4-19-54

Orlg. Data D & A TD 4589
 8" C 161 Stal. 2939 Layton 3410
 KC 3425 B KC 3620 Oswego 3688
 Miss. 4048 Miss. lime 4066 Simp. 4476
 DST 4479-90 open 35 min. Rec. 70' mud
 Simp. sd. 4486 DST 4490-4509 open 1 hr.
 Rec. 1960' sw TD 4589

& A

J. G. McGEHEE

Kansas

Map No. _____ Sec. 2 Twp. 34 R. 2WWell No. 1 Mason

Thos. Berry et al. _____ Company

CORRECTION_____
Contractor

NE NE SW


SECTION PLAT

330 Ft. from N. Line

_____ Ft. from S. Line

330 Ft. from E. Line

_____ Ft. from W. Line

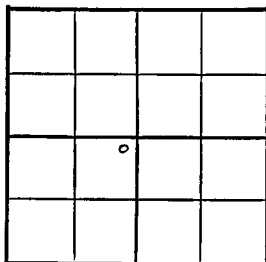

Sumner County

Location _____

Rig up _____

Drilling and Remarks:

Reported

2-34-2E

RECORD

Cased _____ in., _____ ft.

Sand _____

Gas _____

Oil _____

Total Depth _____

PRODUCTION

1st 24 hrs. Nat. _____

1st 24 hrs. after shot _____

Gas _____ Cu. Ft.

Dry Hole _____


Abandoned _____

Date

MAY 5 1959

J. G. McGEHEE Scout

County Sumner State Kansas
 Sec. 2 (Blk.) 34 (Sur.) 2E Map No.
 Operator Thos. N. Derry et al.
 Well No. 1 Farm Mason
 Elev. _____ Location NE NE SW

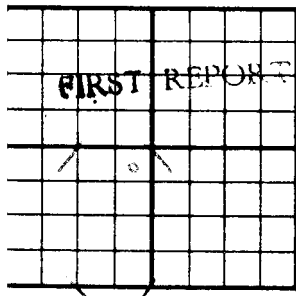

330 Ft. From N Line SW
330 Ft. From E Line Quarter
 Ist. Report APR 27 1954

Completion _____

Remarks CSO - AC

B & R Drlg. - Contr.

Spudding Date 4-19-54

Drlg. Data Wildcat

8" @ 161 drlg. 2300