


Clark KANSAS

DX 78-1

Section 2 Township 34 Range 21W

Well No. 3 Harper


Company Pure Oil

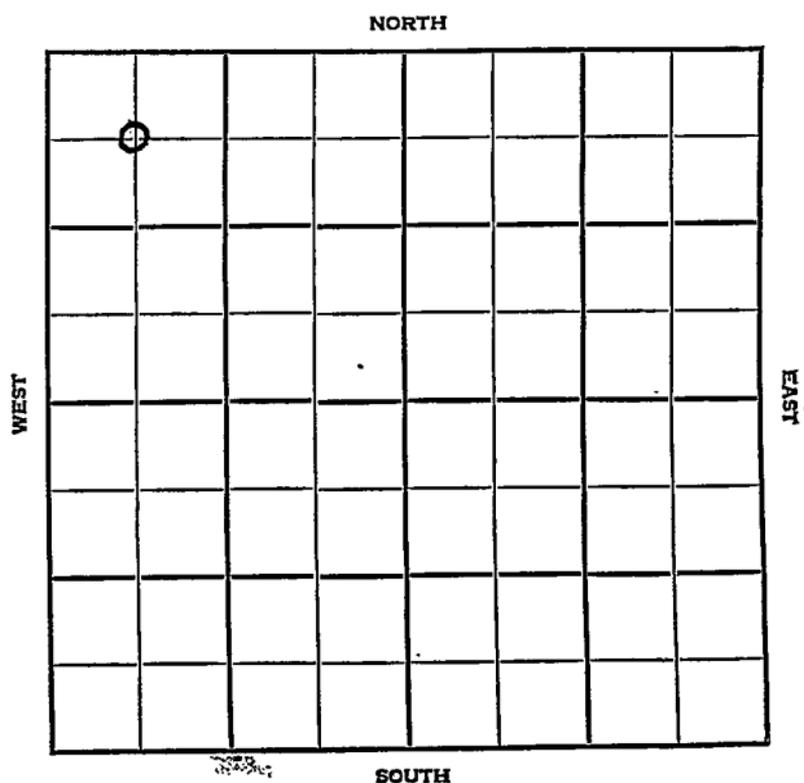

HOT FILE Clark KANSAS

SEC.	2	TWP.	34	R.	21 W
WELL NO.	# 3 Harper FARM				
COMPANY	Pure Oil				
CONTRACTOR	Nye & Snell Harper Ranch Pool				

660 _____ Ft. from N. Line
 _____ Ft. from S. Line
 _____ Ft. from E. Line
 660 _____ Ft. from W. Line

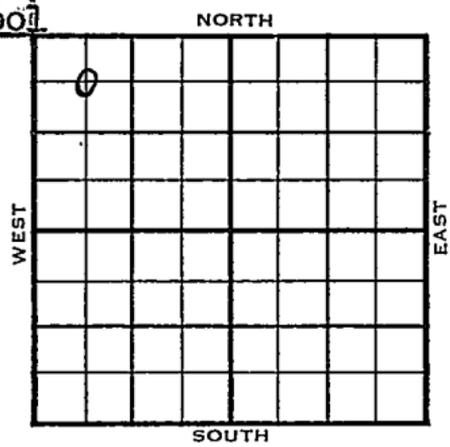

G NW NW

	ELEVATION	REPORT
1954	1924'	
8/4	Spud 7-31-54 16" @ 48 Drlg. 320'	
8/31	10-3/4" @ 581 Anhy 1198' Drlg. 2931'	
10/6	Spud 7-31-54 Oil well TD 5530' 16" @ 48 10-3/4" @ 581 Anhy 1198 Lans. 4548 Marm. 5134 TD 5530 5" @ 5523 Schl tops: Lans. 4547', Marm. 5138', Cherokee 5293', Morrow 5411', Morrow sd 5454', Miss 5488' CO to 5500 TD 5521 40/5457-67 500 M-A sd-oil-frac. F/load. F/285 BO 16 hr. F/35 BO 2 hr. F/114 BO 8 hr. Comp. 243 BOPD	

COMPLETED


County **Clark** State **Kansas**

Sec. **2** (Blk. Twp.) **34** (Sur. Rge.) **21W** Map No.

Operator **Pure Oil**

Well No. **3** Farm **Harper**

Elev. Location **C NW NW**

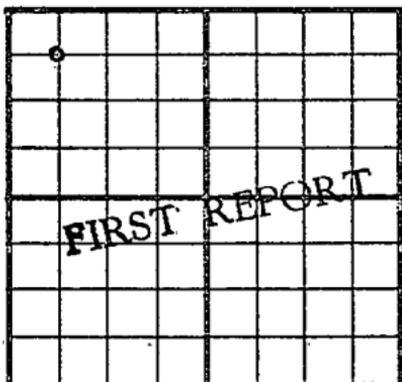

660 Ft. From **N** Line **NW**

660 Ft. From **W** Line Quarter

Ist. Report **AUG 4 1954**

Completion

Remarks

Nye & Snell - Contr.

Spudding Date **7-31-54**

Drlg. Data **Harper Ranch Pool**

16" @ 48 drlg. 320

