

Seward

KANSAS


SECTION 2 TOWNSHIP 34S RANGE 33W

WELL NO. #1 Brown "B"

COMPANY Panhandle Eastern

NORTH

C SW/4

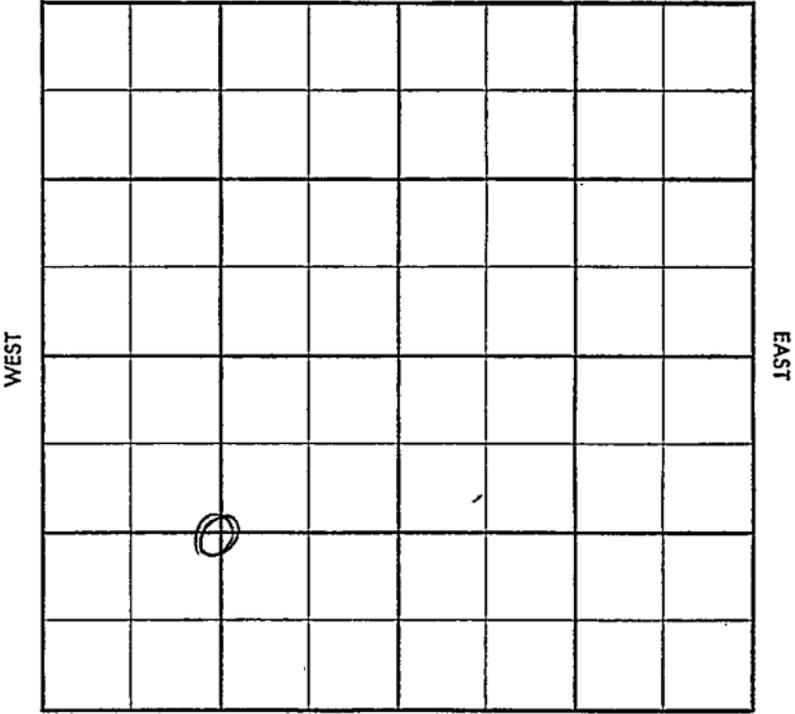

SOUTH

No. No
 Twp. No. No
CORRECTION
 No. No

5-513-B

County Seward Elev. 2850 DF 28530

Sec. 2 Twp. 34 Rge. 33W

Company Panhandle Eastern

Form Name Brown "B" No. 1-2

TOPS	DEPTH.	LOG	DATUM
Anh. <u>Holl</u>		<u>2570</u>	
Tp. <u>NER</u>		<u>2618</u>	
H. <u>Krid</u>		<u>2641</u>	
Tr.			
Dg.			
B.L.			
L.			
K.C.			
B.K.C.			
Ce.			
C.			
M.			
Mr.			
K.			
Mz.			
Mq.			
Y.			
S.			
S.			
A.			
R.			
Pf.			
G.			
T.D.	<u>2760</u>		

Loc. in. Sec. C SW/4

Geol. _____

Contr. Ward

Pool Hugoton

COMPLETE

SEP 3 '58

Date Comm. 5-19-58

Location 7" 689 / 250 Log

4" 2759 / 100 JUN 3 '58 CO 2675

20 / 2670-75 1/2 ga 180 maf + 11

40 / 2650-70 14 / 2630-37 18 / 2619-17

2500A ga 6.63 maf + 20g wph

4 ga 1.262 maf + 20g wph + 5tg

JUN 11 '58 JUN 18 '58 JUN 25 '58 JUL 2 '58 JUL 9 '58 JUL 16 '58

JUL 23 '58 JUL 30 '58 AUG 6 '58 AUG 13 '58 AUG 20 '58

AUG 27 '58 SEP 3 '58 1.262 mCFpd