


KANSAS

DX 78-1 MORTON

Section 2 Township 34 Range 43W

Well No. 1 Interstate

Company Panhandle Eastern

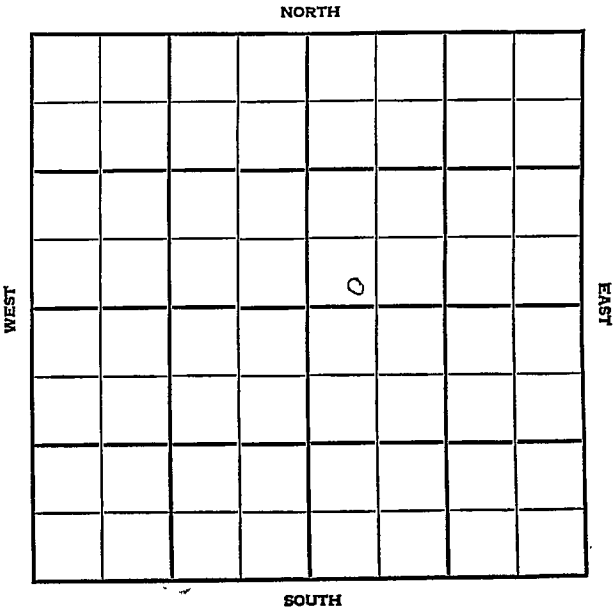

Morton KANSAS

SEC.	TWP.	R.
2	34	43W

WELL NO. **1 Interstate** FARM

COMPANY **Panhandle Eastern**

CONTRACTOR **Falcon-Seaboard**

Greenwood Pool


2388 Ft. from N. Line

_____ Ft. from S. Line

2200 Ft. from E. Line

_____ Ft. from W. Line

C S/2 SW NE

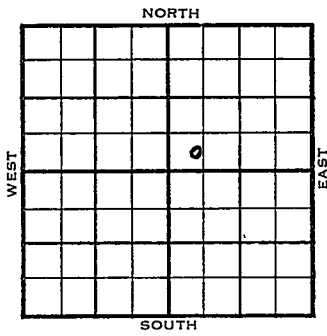

	ELEVATION	REPORT
1955		

3/30	Spud 3-27-55 Reaming @ 680'
------	--------------------------------

MAR 31 1955

Scout Cards	_____	00
Land Small Map	_____	
Land Wall Map	_____	50
Tracings	_____	
France Map	_____	
Pierce Map	_____	
Misc.	_____	