

Map No. KANSAS Sec. 2 Twp. 34 R. 38^w

Well No. 1 - Greenwood Farm

Texas Interstate Oil & Gas Company
M^{rs} Knable NORTH


1320 Ft. from N. Line

_____ Ft. from S. Line

1320 Ft. from E. Line

_____ Ft. from W. Line

1931

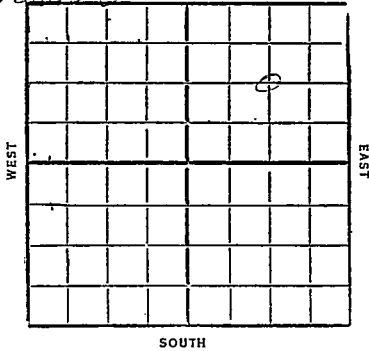

Date	REPORT
1/14	Loc
1/21	—
1/28	—
2/4	—
2/11	Bldg rig
2/18	Ryarr up
2/25	Spud
3/4	4" Drly 2280'
3/11	" 0 2599
3/18	6" 2599 Rust
3/25	Gas 2607
	Drly 2635
	1/2 M gas
4/7	T.D. 2807
	6 1/2 M gas
	Comp

Map No. KANSAS Sec. 2 Twp. 24 R. 28W

Well No. 1 Greenwood

Texas Interstate P. & M. Co. Company

Contractor

SECTION PLAT

1820 Ft. from N. Line

..... Ft. from S. Line

1320 Ft. from E. Line

..... Ft. from W. Line

FIRST REPORTS

Location

Rig up.....

Drilling and Remarks:

RECORD

Cased..... in., ft.

Sand.....

Gas.....

Oil.....

Total Depth.....

PRODUCTION

1st 24 hrs. Nat.....

1st 24 hrs. after shot.....

Gas..... Cu. Ft.

Dry Hole.....

Abandoned.....

Date

JAN 14 1931

S. J. Scout

Stevens

Map No. **KANSAS** Sec. **2** Twp. **34** R. **38**^W

Well No. **1** *Greenwood*

Texas Interstate Oil & Gas Company

Contractor

COMPLETE


SECTION PLAT

1320 Ft. from N. Line

..... Ft. from S. Line

1320 Ft. from E. Line

..... Ft. from W. Line

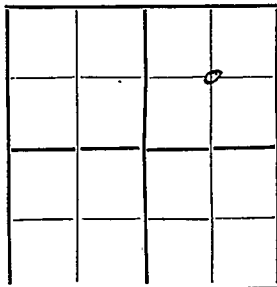

Location.....

Rig up.....

Drilling and Remarks:

RECORD

Cased..... in., ft.

Sand.....

Gas.....

Oil.....

Total Depth 2807

PRODUCTION

1st 24 hrs. Nat.....

1st 24 hrs. after shot.....

Gas 6 1/2 M Cu. Ft.

Dry Hole.....

Abandoned.....

Date

APR 8 1931

CHAS. L. SHERWOOD

192

Scout