


Section 2 Township 34 Range 42W
 Well No. #1 Hill
 Company Panhandle Eastern

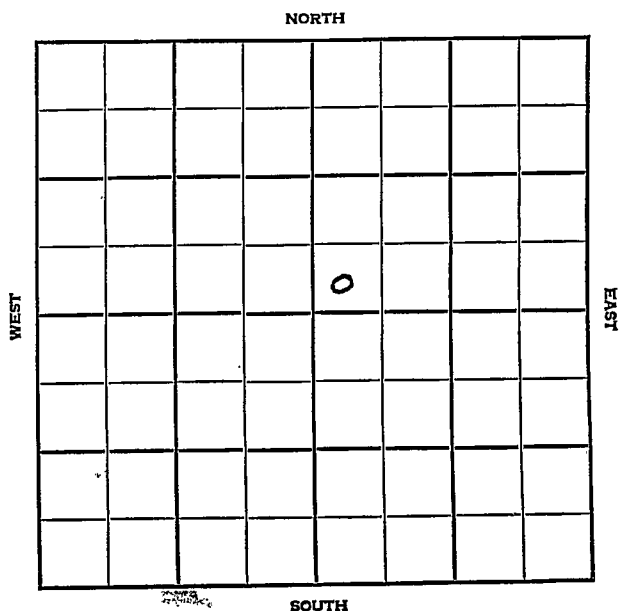

Morton KANSAS

SEC.	TWP.	R.
2	34	42W

WELL NO.

1 Hill

FARM

COMPANY

Panhandle Eastern

CONTRACTOR

Garvey

Greenwood Pool


_____ Ft. from N. Line

2840 _____ Ft. from S. Line

2400 _____ Ft. from E. Line

_____ Ft. from W. Line

SW SWNE

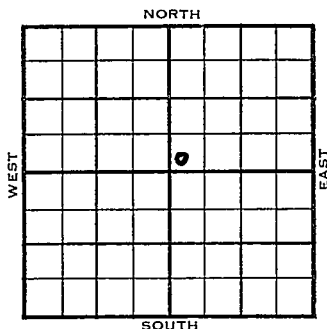

1955	ELEVATION	REPORT
------	-----------	--------

4/13 Spud 4-3-55
10" @ 521'
D rlg. 3174'

FABEN GILSTRAP