

KANSAS

Morton


Section 2 Township 34 Range 41W

Well No. 1 Morton County

Company Cities Service

Wildeat

NORTH

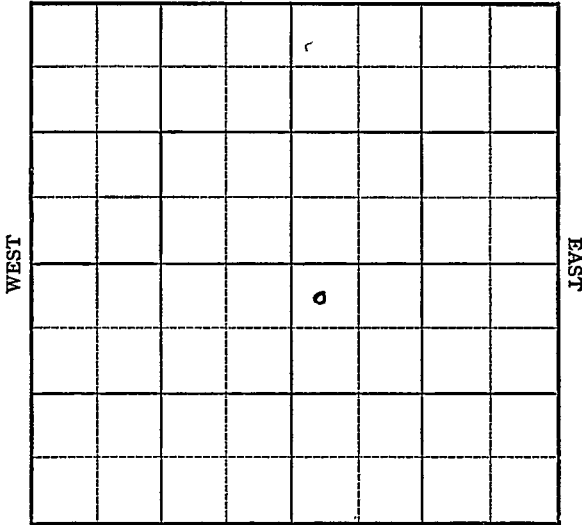

SOUTH

Morton

KANSAS

Sec. 2 Twp. 34 R. 4W ✓

Well No. #1 Morton County Farm.

Cities Service

Company

Wildcat


100' Ft. from N. Line

_____ Ft. from S. Line

_____ Ft. from E. Line

100' Ft. from W. Line

NW SE

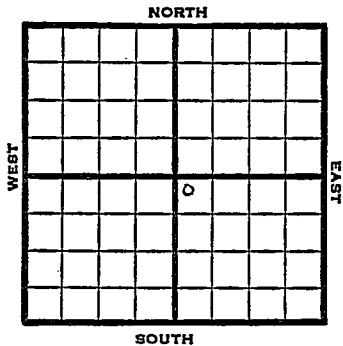

1949 ^E lev 3322' REPORT

6/8 Location

6/15 8" @ 680'

6/21 TD 2690'
5" @ 2535'

6/28 "

7/6 105 shots 2270-2306
35000 acid

7/12 110 shots 2224-46 - 500 acid
14,500 acid

7/20 9000 acid

7/27 "

8/3 TD 2690'
5" @ 2535'
Perf 19000 acid
8,520,000 Gas
408# R Pr.
Camp

COMPLETED

Morton County Kansas State

Map No. _____ Sec. 2 Twp. 34 R. 41W

Well No. 1 Morton County

Cities Service Company

Contractor

NW SE

FIRST REPORT
SECTION PLAT

100 Ft. from N. Line

_____ Ft. from S. Line

_____ Ft. from E. Line

100 Ft. from W. Line

Wildcat
Remarks:

Location

Date JUN 8 1949

Scout

S. J. LEWIS

Kansas

Wildcat

Map No. 1 Sec. 2 Twp. 34 R. 41 W

Well No. 1 Morton County

Cities Service Company

COMPLETE

Contractor

NW SE

F13922

SECTION PLAT

100 Ft. from N. Line

 Ft. from S. Line

100 Ft. from E. Line

 Ft. from W. Line

		o	

Morton Pool

Location

Rig up

Drilling and Remarks:

5" 102535

Prof

19000 cu ft.

8,500,000 Gas

H.S. R.R.

RECORD

Cased in., ft.

Sand

Gas

Oil

Total Depth 2690

PRODUCTION

1st 24 hrs. Nat.

1st 24 hrs. after shot

Gas Cu. Ft.

Dry Hole

Abandoned

Date

AUG 3 1949

S. J. LEWIS Scout