

K.G.S. LIBRARY

21-34-20W

KANSAS DRILLERS LOG

IMPORTANT
Land Dept. Survey request
Samples on this well.

S. 21 T. 34S R. 20 ~~XX~~ W
Loc. 70' FWL & 1250' FSL

API No. 15 — 15 — 033-20,358
County Number

Operator
Texas Oil & Gas Corp.

Address
200 W. Douglas, Suite 300, Wichita, Kansas, 67202

Well No. #1 Lease Name Woolfolk "A"

Footage Location
1250' feet from ~~XX~~ (S) line 70' feet from ~~XX~~ (W) line


Principal Contractor Xplor Rig #1 Geologist Bill Sladek

Spud Date 6-20-80 Total Depth 5527' P.B.T.D. N/A

Date Completed 7-3-80 Oil Purchaser N/A

County Comanche

640 Acres
N

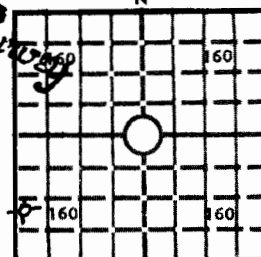

Locate well correctly

Elev.: Gr. 1747'

DF KB 1755'

CASING RECORD

Report of all strings set — surface, intermediate, production, etc.

Purpose of string	Size hole drilled	Size casing set (in O.D.)	Weight lbs/ft.	Setting depth	Type cement	Sacks	Type and percent additives
Surface		8-5/8"		1005'		300 sxs	bottom
						460 sxs	top

LINER RECORD

PERFORATION RECORD

Top, ft.	Bottom, ft.	Sacks cement	Shots per ft.	Size & type	Depth interval
N/A	N/A	N/A	N/A	N/A	N/A
TUBING RECORD					
Size	Setting depth	Packer set at			
N/A	N/A	N/A			


ACID, FRACTURE, SHOT, CEMENT SQUEEZE RECORD

Amount and kind of material used	Depth interval treated
N/A	N/A

INITIAL PRODUCTION

Date of first production		Producing method (flowing, pumping, gas lift, etc.)			
D & A, 7-3-80		N/A			
RATE OF PRODUCTION PER 24 HOURS	Oil	Gas	Water	Gas-oil ratio	
	N/A	bbls. N/A	MCF N/A	bbls. N/A	CFPB
Disposition of gas (vented, used on lease or sold)			Producing interval(s)		
D & A			N/A		

INSTRUCTIONS: As provided in KCC Rule 82-2-125, within 90 days after completion of a well, one completed copy of this Drillers Log shall be transmitted to the State Geological Survey of Kansas, 4150 Monroe Street, Wichita, Kansas 67209. Copies of this form are available from the Conservation Division, State Corporation Commission, 3830 So. Meridian (P.O. Box 17027), Wichita, Kansas 66217. Phone AC 316-522-2206. If confidential custody is desired, please note Rule 82-2-125. Drillers Logs will be on open file in the Oil and Gas Division, State Geological Survey of Kansas, Lawrence, Kansas 66044.

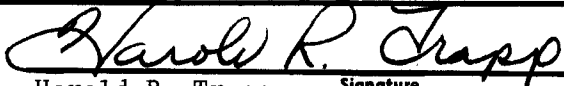Operator Texas Oil & Gas Corp.		DESIGNATE TYPE OF COMP.: OIL, GAS, DRY HOLE, SWDW, ETC.: Dry Hole	
Well No. #1	Lease Name Woolfolk "A"		
S 21 T 34 S R 20 E W			
WELL LOG		SHOW GEOLOGICAL MARKERS, LOGS RUN, OR OTHER DESCRIPTIVE INFORMATION.	
Show all important zones of porosity and contents thereof; cored intervals, and all drill-stem tests, including depth interval tested, cushion used, time tool open, flowing and shut-in pressures, and recoveries.			
FORMATION DESCRIPTION, CONTENTS, ETC.	TOP	BOTTOM	NAME
DEPTH			
LOG TOPS			
Heebner	4239	-2484	
Douglas	4314	-2559	
Lansing	4434	-2679	
Swope	4898	-3143	
Base Kansas City	4999	-3244	
Marmaton	5030	-3275	
Cherokee	5193	-3438	
Morrow	5316	-3561	
Morrow Sand	5390	-3635	
Mississippian	5452	-3697	
TD	5527		
Ran O.H. Logs DST #1, 5540-5426' (Morrow), w/results as follows: pkr failure, misrun DST #2, 5320-5426' (Morrow), w/results as follows: IFP/30": 177-300# ISIP/60": 2067# FFP/45": 355-423#, GTS 20" TSTM FSIP/90": 2054# Rec: 183 GCM, Chl 28,000 ppm, 305 GCMW, 86,000 ppm, 732 GCW, 108,000 ppm, temp. 132°F			
USE ADDITIONAL SHEETS, IF NECESSARY, TO COMPLETE WELL RECORD.			
Date Received	 Harold R. Trapp District Geologist		
	Signature Title		
	July 15, 1980 Date		

31-34-30m

15-033-20358

WELL LOG

21-34-20w

Woolfolk 'A' 1

State Geological Survey
WICHITA BRANCH
 copy

OPERATOR: Texas Oil & Gas
 CONTRACTOR: Xplor Drilling Co., Inc.

COMMENCED: June 21, 1980
 COMPLETED: July 2, 1980
 CASING RECORD: 8 5/8" @ 999'

<u>FORMATION</u>	<u>FROM</u>	<u>TO</u>
Red Bed & Shale	0	1027
Shale	1027	1530
Dold & Shale	1530	2130
Shale	2130	2308
Lime & Shale	2308	2700
Dold	2700	3400
Lime & Shale	3400	5426
Mississippi	5426	5527

STATE OF KANSAS)
) SS:
 COUNTY OF SEDGWICK)

I certify that this is a true and correct copy of the Driller's Log on the well drilled 1250' FSL 7 70' FWL, Sec. 21-34-20W, Comanche Cty, Kans. to the best of my knowledge and belief.

RECEIVED
 STATE CORPORATION COMMISSION

JUL - 7 1980
 CONSERVATION DIVISION
 Wichita, Kansas

XPLOR DRILLING COMPANY