


STATE OF KANSAS
STATE CORPORATION COMMISSION

WELL PLUGGING RECORD

ve All Information Completely
Make Required Affidavit
Mail or Deliver Report to
Conservation Division
State Corporation Comm.
245 North Water
Wichita, KS 67202

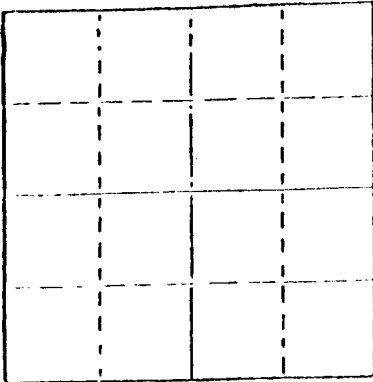

Locate well correctly on above
Section Plot

Comanche County, Sec. 33 Twp. 34S Rge. 20 E
Location as "NE/CNW/SW" or footage from lines

C NE NE

Lease Owner Energy Reserves Group, Inc.

Lease Name Geneva Robbins Well No. #1

Office Address 5015 N. Pennsylvania, Suite 100, Okla. City

Character of Well (Completed as Oil, Gas or Dry Hole) OK

Dry Hole

Date Well completed 7-13-77 19

Application for plugging filed 7-13-77 19

Application for plugging approved 7-13-77 19

Plugging commenced 7-13-77 19

Plugging completed 7-13-77 19

Reason for abandonment of well or producing formation

Commercial quantities of oil not found.

If a producing well is abandoned, date of last production

19

Was permission obtained from the Conservation Division of

its agents before plugging was commenced? Yes

Name of Conservation Agent who supervised plugging of this well Bud Metz, Stafford, Kansas

Producing formation Depth to top Bottom Total Depth of Well 54

Show depth and thickness of all water, oil and gas formations.

OIL, GAS OR WATER RECORDS

CASING RECORD

FORMATION	CONTENT	FROM	TO	SIZE	PUT IN	PULLED OUT
				8 5/8"	670'	None

Describe in detail the manner in which the well was plugged, indicating where the mud fl was placed and the method or methods used in introducing it into the hold. If cement or of plugs were used, state the character of same and depth placed, from feet to feet for each plug set.

Plug @ 700' w/40 sx.

Plug @ 240' w/20 sx.

Plug @ 40' w/12 sx.

Rat Hole 3 sx.

(If additional description is necessary, use BACK of this sheet)

Name of Plugging Contractor Rains & Williamson Oil Co., Inc.

STATE OF Kansas COUNTY OF Sedgwick, ss.

Wilson Rains, President of Rains & Williamson Oil Co., Inc. (employee of owner) or (owner or opera of the above-described well, being first duly sworn on oath, says: That I have knowledge o and matters herein contained and the log of the above-described well