


Barber

KANSAS

SECTION 20 TOWNSHIP 34 RANGE 12 W

WELL NO. #1 Robert B. Cook

COMPANY Magnolia Pet.

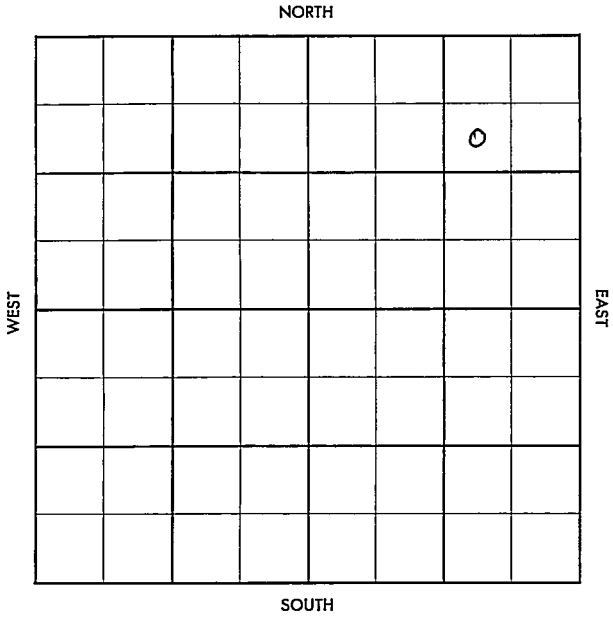

Barber

KANSAS

SEC.	TWP.	R.
20	34	12W

WELL NO.

#1 Robert B. Cook

FARM

COMPANY

Magnolia Pet Co.

CONTRACTOR

G-M-R

Hardtner


_____ Ft. from N. Line

_____ Ft. from S. Line,

_____ Ft. from E. Line

_____ Ft. from W. Line

SW NE NE

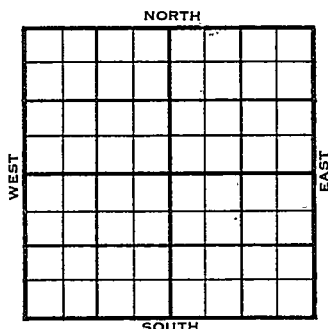

	ELEVATION	REPORT
1955	11480	

11/16

Comm 11-12-55
 9" @ 355/300
 Drlg 1972

12-14

5 $\frac{1}{2}$ " @ 4829-200
 CO to 4796 48/ 4740-52
 S/ 5 gwph 5 hrs., viso-frac
 F/ 1,456 mcfg
 F/ 4,320 mcfg
 F/ 7,120 mcfg
 SP 4734, 72/ 4712-30
 F/ 1,790 mcfg, viso-frac
 F/ 5,890 mcfg
 Comp. open flow 5,300 mcfgpd, 1896#.
 Anh. 600-15
 H. 3803
 Elg. Sd. 3573
 L. 4006
 KC 4309
 Burg. Sd. 4701-4696
 M. 4713-4708
 TD 4830'

COMPLETED

County Barber Elev. 1180
 Sec. 20 Twp. 34 Rge. 12W
 Company Magnolia Pet.
 FarmName Robert B. Cook No. 1

TOPS	DEPTH	LOG	DATUM	Loc. in Sec.									
Anh.				SW NE NE									
TP.													
H.													
Tr.													
Dg.													
Bl.													
L.				Geol.									
K.C.				Contr.									
B.K.C.				<u>G-M-R</u>									
Ce.				Pool									
C.				<u>Hardtner</u>									
M.				<table border="1"> <tr><td></td><td></td><td></td></tr> <tr><td></td><td></td><td>o</td></tr> <tr><td></td><td></td><td></td></tr> </table>						o			
		o											
M.													
K.													
Mz.													
Me.													
V.													
S.													
S.													
A.													
R.													
PE.				FIRST REPORT									
G.													
T.D.													

Date Comm. 11-12-55 ~~NOV 19 1955~~
9" @ 355/300 drlg. 1972 NOV 16 1955

26

NOV 21 1955

Scout Cards	mmmc
Land Small Map	_____
Land Wall Map	_____
Tracings	_____
France Map	_____
Pierce Map	_____
Misc.	_____

County **Barber** Elev. **1180**
 Sec. **20** Twp. **31** Rge. **12W**
 Company **Magnolia**
 Farm Name **Robert B. Cook** No. **1**

TOPS	DEPTH	LOG	DATUM	Loc. in Sec.
Anh.	600-15			SW NE NE
Tr.	3803		2323	1150' NL
Dg.				1050' EL
Br. <i>E19 sp</i>	3573		1093	
L.	4006		2526	
K.C.	4309		2029	Geol.
B.K.C.				Contr.
C. <i>Bungsd</i>	4701	4696	3216	G-M-R
M.	4713	4708	3228	Pool
M.				Hardtner
K.				
Mz.				
Me.				
V.				
S.				
S.				
A.				
R.				
Pe.				
G.				
TD.	4820			

COMPLETE

Date Comm. **11-12-55** DEC 14 1955

9" @ 355/300 5 1/2" @ 4829/200

CO to 4796 48/ 4740-52 S/ 5 gwph 5 hr.

viso-frac F/ 1,456 mcfg F/ 4,320 mcfg

F/ 7,120 mcfg SP 4734 72// 4712-30

F/ 1,790 mcfg viso-frac F/ 5,890 mcfg

Comp. open flow 5,300 mcfgpd 1896#

DEC 29 1955

R. G.