


Barber KANSAS

SECTION 20 TOWNSHIP 34 RANGE 13 W

WELL NO. # 1 Hull

COMPANY E. H. Adair

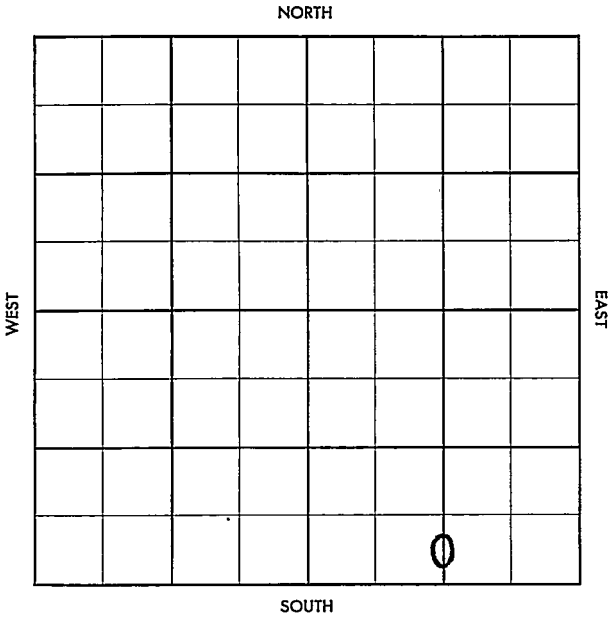

SEC.	TWP.	R.
20	34	13W

WELL NO.

#1 Hull

FARM

COMPANY

E.H. Adair

CONTRACTOR

Co. Tools

WILDCAT


NORTH

\_\_\_\_\_ Ft. from N. Line

\_\_\_\_\_ Ft. from S. Line

\_\_\_\_\_ Ft. from E. Line

\_\_\_\_\_ Ft. from W. Line

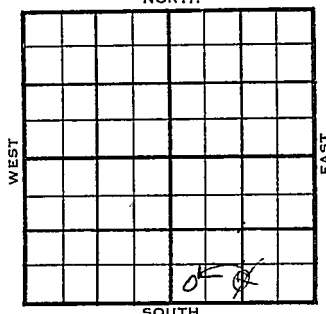

~~E S $\frac{1}{2}$  S $\frac{1}{2}$  SE~~  
SW SW SE

Atl. - DHM

1956	ELEVATION	REPORT
	1652'	
4-18	Comm. 4-12-56 8" @ 323 w/270 Drlg. 2400	
5-23	DST 4140-60 op 45 min, rec. 12' mud, BHP 240/30". DST 4165-85 op 1 hr. rec. 750' SW, BHP 720/20 DST 4775-4801 op 90 min, rec. 10' mud, 240/20" DST 4804-34 op 90 min, rec. 260' GCM / 120' <del>W</del> W gssy mud, BHP 1980/20". 5 1/2" @ 4794 w/100 CO 4854, SSG / oil, Frac, ga 1 mill. decl. to 400 MCF / 2 BFPH (mostly wtr.) D & A Elg. 3798 3787 Elg Sd. 3859 Hb. 3981 3974 Tr. 4010 4008 Dg. 4066 4064 L. 4161 4161 C. 4781 4779 M.Dolo 4791 4789 TD 4854'	

County Barber Elev. \_\_\_\_\_  
 Sec. 20 Twp. 34 Rge. 13W  
 Company E. H. Adair  
 Farm Name Hull No. 1

TOPS	DEPTH	LOG	DATUM
Anb.			
Tr.			
H.			
Tr.			
Dg.			
Bl.			
L.			
K.C.			
B.K.C.			
Ce.			
C.			
M.			
M.			
K.			
Mz.			
Me.			
V.			
S.			
S.			
A.			
R.			
Pe.			
G.			
TD.			

Loc. in Sec. C S $\frac{1}{2}$  S $\frac{1}{2}$  SE

Geol. \_\_\_\_\_

Contr. Co. tools

Pool Wildcat

APR 18 1956	
FIRST REPORT	

Date Comm. 4-12-56 Atl. - DHM  
8" @ 323/270 drlg. 2400

APR 24 1956

R. G.

Co.  
Lse.  
No.  
Sec.  
T.  
R.

## CORRECTION

Co.

Use

No.

Sec.

T.

R.

County Barber Elev. 1652  
 Sec. 20 Twp. 34 Rge. 13W  
 Company E. H. Adair  
 Farm Name Hull No. 1

TOPS	DEPTH	LOG	DATUM	Loc. in Sec.
Anh.				
Tp. <u>E19</u>	<u>2797</u>	<u>3787</u>		<u>4 S1 S1 SE</u>
H. <u>" sd</u>	<u>3859</u>			<u>SW SW</u>
Tr. <u>H6</u>	<u>3981</u>	<u>3974</u>		
Dg. <u>TR</u>	<u>4010</u>	<u>4008</u>		
Bl. <u>D9</u>	<u>4066</u>	<u>4064</u>		
L. <u></u>	<u>4161</u>	<u>4161</u>		
K.C.				Geol. _____
B.K.C.				Contr. _____
Ce. _____				So. tools _____
C. _____	<u>4781</u>	<u>4779</u>		Pool _____
M. <u>Delo</u>	<u>4791</u>	<u>4789</u>		Fill out _____
M. _____				
K. _____				
Mz. _____				
Me. _____				
V. _____				
S. _____				
S. _____				
A. _____				
R. _____				
PC. _____				
G. _____				
T.D. <u>4854</u>				

ABANDONED

MAY 28 1956  
e ADate Comm. 11-18-56 tl. - "I"

8" @ 323/270 2-7-56 9:00 APR 25 '56 DST  
4140-60 45" rec 12' Md BHP  
240/30 MAY 2 '56 DST 4165-85 1hr  
750' SW BHP 720/20 @ 4762  
MAY 9 '56 DST 4775-4801 90" rec  
10' Md 240/20" DST 4804-34  
90" rec 260' GCM + 120' Wgssy  
Md BHP 1980/20" 5 1/2 @ 4794/100  
MAY 16 '56 CO 4854 SSG + oil 1/2 Frac

FORM 513-1 SUNRAY

MAY 23 '56

9a 1 Mill. decl. TO  
400 MCF + 2 BFPH (Mostly  
Wtr

D & A