

Barber

KANSAS

20

34

14W

SECTION \_\_\_\_\_ TOWNSHIP \_\_\_\_\_ RANGE \_\_\_\_\_


#1 Hirsh

WELL NO. \_\_\_\_\_

Wm. Gruenerwald

COMPANY \_\_\_\_\_

NORTH

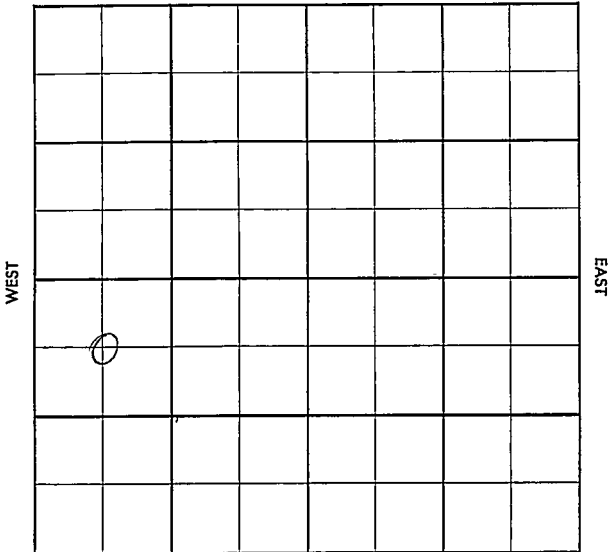

SOUTH



County Barber Elev. 1579  
 Sec. 20 Twp. 34 Rge. 14W  
 Company Wm. Cruenerwald  
 Farm Name Nirsch No. 1

	TOPS	DEPTH	LOG	DATUM
Anh.	<u>LeCPH</u>		<u>3635</u>	
Tp.	<u>E19</u>	<u>3698</u>	<u>3677</u>	
H.	<u>" sd</u>	<u>3795</u>	<u>3728</u>	
Tr.	<u>H6</u>	<u>3875</u>		
Dg.	<u>TR</u>	<u>3892</u>	<u>3892</u>	
Bl.	<u>D9</u>	<u>3916</u>	<u>3918</u>	
L.	<u>" sd</u>	<u>3929</u>		
K.O.	<u>L59</u>	<u>4103</u>	<u>4089</u>	
B.K.C.				
Co.	<u>Marm</u>		<u>4619</u>	
C.e			<u>4706</u>	
M.		<u>4737</u>	<u>4736</u>	<u>- 3/57</u>
M.				
K.				
Mz.				
Mo.				
V.				
S.				
S.				
A.				
R.				
PE.				
G.				
T.D.		<u>4805</u>		

Loc. in Sec. C NW SW  
 Geol. ---  
 Contr. ---  
 Fatton Tools  
 Pool  
 Wildcat  
**COMPLETE**  
 JAN 9 '57

Date Comm. Charclin (AC)  
RURT OCT 3 56 9-26-56 13 3/8 @  
197/200 85/8 862/200  
11616 OCT 10 56 3580 Oct 17 56  
DST 3695-3740 7hr rec 850'  
SW BHP 1430/15" DST 3914  
-46 ex 1hr rec 1410' SW FP  
290-715 BHP 1395/15" 4150  
OC. 24 50 DST 4735-50 90" 6/1"  
9a 1,350 MCFG 1/2" 1,350 MCFG

end of tst rec 3' Md BHP  
 1200/20 DST 4750-70 90"  
 840' GIP rec 30' Md BHP  
 240/20" 5 1/2 @ 4795/200 CC: 31 '56  
 CO 4786 40/4774-84 FU  
 575' wtr 8 hrs (550) 1/2  
 \$ 157 BW no time \$ 14 BF  
 (mostly wtr) 3 hrs ga 734  
 MCFG - NOV 7 '56 To PB' NOV 13 '56 NOV 21 '56  
 NOV 29 '56 MICT DEC 5 '56 W.O.O. DEC 12 '56  
 PB 4766 48/4742-54  
 1/2 est ga 1,500 MCF  
 Frac Flwd 9 1/2/100 BF 1hr  
 78% oil + 18% BS + 4% wtr  
 FTP 200 wost +st, DEC 25 '56 JAN 2 '57  
 ga 3,300 MCFG  
 SIP 1600#