

Map No. *W-1000* Sec. *20* Twp. *34* R. *13w*


Well No. *1-Blunk* Farm
Barber Oil Company

660 Ft. from N. Line

_____ Ft. from S. Line


660 Ft. from E. Line

_____ Ft. from W. Line

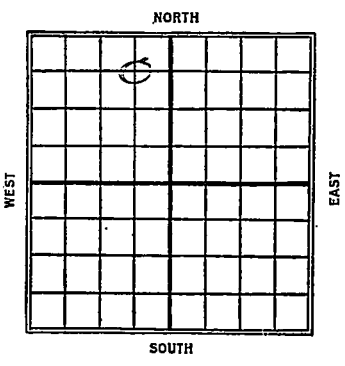

1927

Date	REPORT
<i>12/14</i>	<i>P. O. G.</i>
<i>12/21</i>	<i>No report.</i>
<i>12/28</i>	<i>Spud</i>
<i>1928</i>	
<i>1/4</i>	<i>Drly 150'</i>
<i>1/11</i>	<i>T.D. 150 - S.D.</i>
<i>1/18</i>	<i>—</i>
<i>1/25</i>	<i>Drly 365.</i>
<i>1/31</i>	<i>" 715</i>
<i>2/15</i>	<i>T.D. 1610 - u.R. 10"</i>
<i>2/22</i>	<i>Drly 1718 -</i>
<i>2/27</i>	<i>2200</i>
<i>2/29</i>	<i>T.D. 1980 - S.D.</i>
<i>3/7</i>	<i>Drly 2520</i>
<i>3/14</i>	<i>Runy 10" @ 2660 -</i>
<i>3/21</i>	<i>T.D. 2765 - u.R. 10"</i>
<i>3/28</i>	<i>—</i>
<i>4/4</i>	<i>Drly 2870</i>
<i>4/11</i>	<i>" 2965</i>
<i>4/18</i>	<i>T.D. 3275 - u.R. 8"</i>
<i>4/25</i>	<i>—</i>
<i>5/2</i>	<i>T.D. 3510 - u.R. 8"</i>

5/9 - T.D. 3540 fishing tools - 
 5/16 - Drlg. 3570 -
 5/23 - no report -
 5/31 - T.D. 3650 - S.D.
 6/6 - T.D. 3650 - u.R. 8"
 6/13 - Drlg 3750 -
 6/20 - " 3940
 6/27 - T.D. 3970 - drlg up u.R. lugs -
 7/3 - Drlg. 4050 - 2 ~~at~~ gas -
 7/11 - T.D. 4125 - u.R. 8"
 7/18 - fsg tools - T.D. 4125 -
 7/25
 8/1 - Drlg. 4130 -
 8/17 - T.D. 4130 - drlg by tools
 8/15 - S.D. 4130
 8/22 - T.D. - fsg 4130"
 9/5 - 8" @ 4165
 9/12 - drlg. 4195
 9/19 - " 4260
 9/26 - " 4355'
 10/3 - " 4387'
 10/10 - S.D. 4521 - T.D.
 10/17 - Drlg 4570'
 10/24 - " 4655'
 10/31 - T.D. 4715 - SD for 4"
 11/7 - Drlg 4715'
 11/14 - TD 4755
 Str team 6"
 11/21 _____
 11/28 _____
 12/5 _____
 12/12 _____
 12/19 _____
 12/26 no report
 1929 _____
 1/2 _____
 1/9 - cem 6" - 4755' - T.D.
 1/16 _____

Map No. *no map* **KANSAS** Sec. *20* Twp. *34* R. *13W*

Well No. *1 Blank*

Barter Oil Company

Contractor

SECTION PLAT

	0		

660 Ft. from N. Line

_____ Ft. from S. Line

660 Ft. from E. Line

_____ Ft. from W. Line

FIRST REPORTS

Location _____

Rig up _____

Drilling and Remarks:

ROG

RECORD

Cased _____ in., _____ ft.

Sand _____

Gas _____

Oil _____

Total Depth _____

PRODUCTION

1st 24 hrs. Nat. _____

1st 24 hrs. after shot _____

Gas _____ Cu. Ft.

Dry Hole _____

Abandoned _____

Date

DEC 14 1927

S. J. LEWIS Scout

No small map

No wall map

Returned
to: <i>Love</i>
and Map
Scarborough Map <input checked="" type="checkbox"/>
Moody Map
Scarborough Flat Book
Moody Flat Book

Barber

Map No. **KANSAS** Sec. *20* Twp. *34* R. *12W*

Well No. *1 Blunk*

Barber Oil Company

Contractor

SECTION PLAT

660 Ft. from N. Line

..... Ft. from S. Line

660 Ft. from E. Line

..... Ft. from W. Line

	0		

ABANDONED

Location.....

Rig up.....

Drilling and Remarks:

5395 in line

JJA

RECORD

Cased..... in., ft.

Sand.....

Gas.....

Oil.....

Total Depth..... *5395*

PRODUCTION

1st 24 hrs. Nat.....

1st 24 hrs. after shot.....

Gas..... Cu. Ft.

Dry Hole.....

Abandoned.....

Date

MAR 27 1929

192.....

S. J. LEWIS

Scout

small
no welling

Returned	
Cards	Three
Tracing	None
France Map	
Scarborough Map	X
Moody Map	
Scarborough Plat Book	
Moody Plat Book	