


Section 20 Township 34 Range 31W

Well No. 1-B 2 Good

Company Lanskan

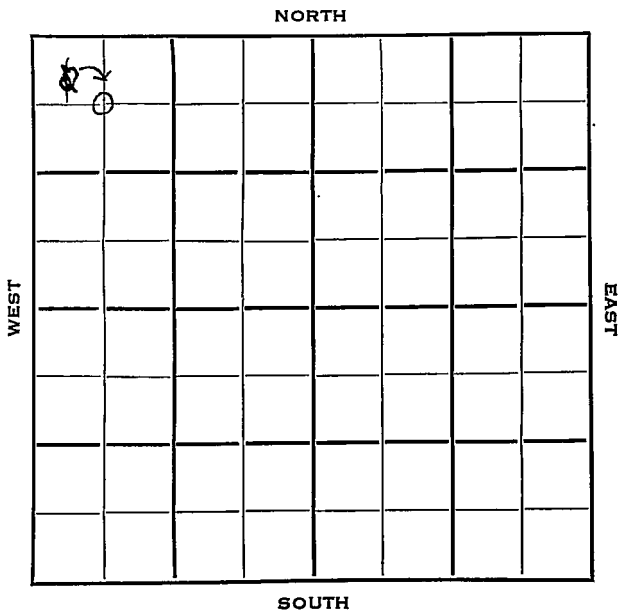

Seward

KANSAS


SEC. 20	TWP. 34	R. 31W ✓
---------	---------	----------

WELL NO. ~~#1~~ ~~#2~~ **#3** Good FARM

COMPANY **Lanskan**

CONTRACTOR **Schaeffer**

~~330~~ **660** Ft. from N. Line
 _____ Ft. from S. Line
 _____ Ft. from E. Line
~~330~~ **660** Ft. from W. Line

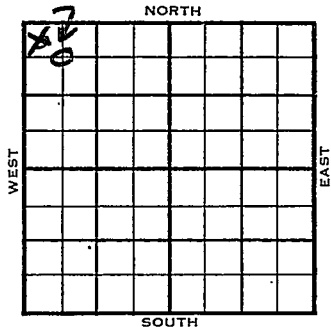

C
~~NW~~ NW NW

1953	ELEVATION	REPORT
	2720'	

Miss. Test.

11/11 Location
 11/18 13" @ 708'
 Drlg 947'

1954
 3/31 Spud 11-12-53 Gas well TD 6456
 13" @ 708 9" @ 2727
 DST 4841-61 open 1 hr rec 100' OCM &
 SW. 1050#
 DST 4860-75 open 1 hr rec 110' OCM
 245' SW. DST 5306-15 open 1 1/4 hr, rec
 65' mud, 120' SW 1610#
 Cored 5804-44, rec 33 1/2', Morrow 5783'
 DST 5949-79 open 2 hr rec 1/2 MCFG,
 309' GCM, 1764#
 DST 5985-6016 open 1 hr rec 10' mud
 45# Miss 5945' TD 6456 5" @ 6013
 CO to 5972 108/5947-65 1000 A
 4000 A Lans. 4388' Marm 5210'
 Cherokee 5442' Atoka 5605'
 Miss. 5928' St. Gen. 6226
 St. Louis 6395'
 Comp. 1,700,000 gas.

COMPLETED

County Seward State Kansas

Sec. 20 (Blk. Twp.) 34 (Sur. Rge.) 31W Map No.

Operator Lanskan

Well No. 2 Farm Good

Elev. Location NW NW NW

6					

330 Ft. From N Line NW

330 Ft. From W Line Quarter

1st. Report NOV 11 1953

Completion

Remarks Miss. test

Schaeffer - Contr.

Spudding Date

Drlg. Data

Location

Route Cards
Small P.
Large Vrail M.
Tracings
France Map
Pierce Map
Misc.

NOV 12 1953

Orig. Data

33

Kansas

Map No. _____ Sec. 20 Twp. 34 R. 31W

Well No. 1-B Good

Lanskan

Company

CORRECTION

Contractor

C NW NW

SECTION PLAT

660 Ft. from N. Line

_____ Ft. from S. Line

_____ Ft. from E. Line

660 Ft. from W. Line

o			

Seward County

Location _____

Rig up _____

Drilling and Remarks:

Reported

NW NW NW

#2 Good

RECORD

Cased _____ in., _____ ft.

Sand _____

Gas _____

Oil _____

Total Depth _____

PRODUCTION

1st 24 hrs. Nat. _____

1st 24 hrs. after shot _____

Gas _____ Cu. Ft.

Dry Hole _____

Abandoned _____

Date

DEC 2 1933

J. G. McGEHEE Scout

202

Joe,

Does this correction ticket correct
the well NO. too? It was reported

#2

Luville

Mr. ...

Spot Cards	MM
Land Small Map	
Land Well Map	B
Tracings	
France Map	
Mapce Map	
Misc.	

DEC 8 1953

21

42

7

Scout Cards	<i>MM</i>
Land Smart Map	
Land Wall Map	<i>B</i>
Tracings	
France Map	
France Map	
Misc.	

APR 6

1954

Dirg. Data