

Section 20 Township 34 Range 33WWell No. #1 StevensonCompany Cities Service

NORTH

			0				

WEST

EAST

SOUTH

KANSAS
34

Seward
33-W

Sec. 20 Twp. R.

Well No. #1 Stevenson Farm

Cities Service Company

Hugoton

Contractor


Ft. from N. Line

100 Ft. from S. Line

100 Ft. from E. Line

Ft. from W. Line

SE NW

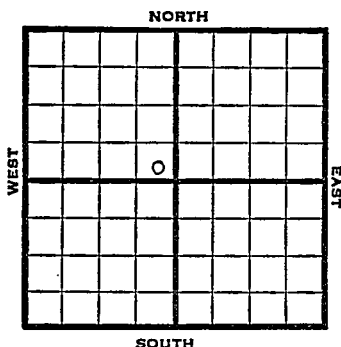

1950

Elev. 2863'

REPORT

7/26

Location

9/20

TD 2760' Gas Well

8" @ 680' 5" @ 2759'

TD 2760'

Her. 2600' Krider 2624'

Win 2714'

Co to 2740 13/2710-36

160/2656-88 50/2624-34

30/2600-06 20/2590-94

18,000 total acid

Comp. 10,500,000 gas.

COMPLETED

Map No. _____ Sec. 20 Twp. 34 R. 33WWell No. 1 Stevenson

Cities Service

Company

Contractor

SE NW

SECTION PLAT

	0		

FIRST REPORT

_____ Ft. from N. Line

100 Ft. from S. Line100 Ft. from E. Line

_____ Ft. from W. Line

Seward County

Location X

Rig up _____

Drilling and Remarks:

RECORD

Cased _____ in., _____ ft.

Sand _____

Gas _____

Oil _____

Total Depth _____

- PRODUCTION

1st 24 hrs. Nat. _____

1st 24 hrs. after shot _____


Gas _____ Cu. Ft.

Dry Hole _____

Abandoned _____

Date

JUL 26 1950 19J. E. TYRA Scout

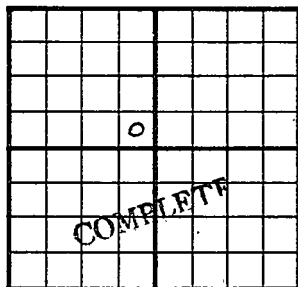County Seward State KansasSec. 20 (Blk.
Twp.) 34 (Sur.
Rge.) 33W Map No.Operator Cities ServiceWell No. 1 Farm StevensonElev. 2863 Location SE NW100 Ft. From S Line NW100 Ft. From E Line Quarter

1st. Report

Completion SEP 20 1950

Remarks

Hugoton Pool

Spudding Date

Drilg. Data Gas well TD 27608" @ 680 5" @ 2759 TD 2760Her. 2600 Krider 2624 Win. 2714CO to 2740 130/ 2710-36 160/ 2656-8850/ 2624-34 30/ 2600-06 20/ 2590-9418000 total acid Comp. 10,500,000 gas

J. E. TYRA