


Section 20 Township 34 S Range 13 W

Well No. #3 Interstate (Block "A")

Company Huber

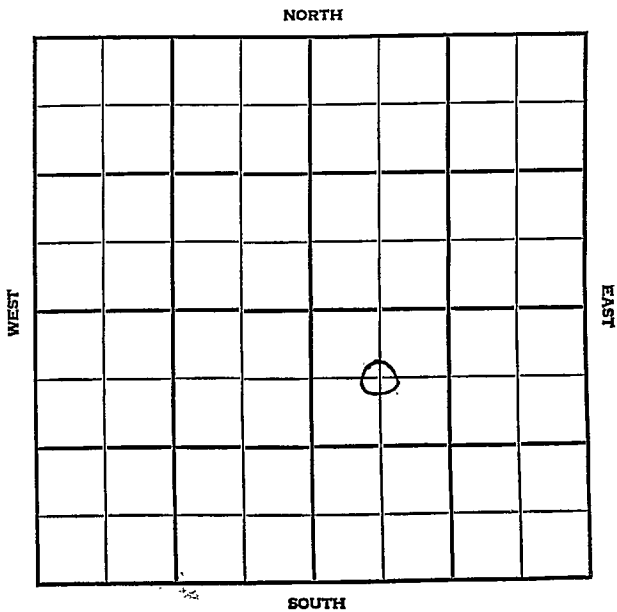

MORTON

KANSAS

SEC.	TWP.	R.
20	34S	43W

WELL NO.

#3 Interstate (Block "A")

FARM

COMPANY

Huber

CONTRACTOR

Co Tools  
Interstate

\_\_\_\_\_ Ft. from N. Line


\_\_\_\_\_ Ft. from S. Line

\_\_\_\_\_ Ft. from E. Line

\_\_\_\_\_ Ft. from W. Line

C NW SE

PEPL - FO

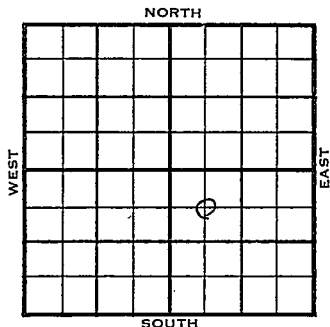

1955

ELEVATION

3482'

REPORT

9/21

Comm 9-17-55  
13" @ 80' w/100  
8" @ 1100 w/700  
D 2475

10/26

Comm 9-17-55  
13" @ 80/100  
8" @ 1100 w/700

Tp 2670

L 2898 2902

Morrow 4057 4052

1st sd 4105 4107

2nd sd 4113

Purdy 4151

Purdy sd 4232

TD 4260 4259 1/2

DST 4100-20 open 1 hr gas in 13 min

60 mcfg 120' vsocm 450' so &amp; gcsw

975/20" DST 4147-88 open 55 min

gas in 5 min 375 mcg F/oil in 47 min

rec 990' clean oil 90' sw 1125/20"

5 1/2" @ 4219/600 CO to 4184 24/4172-76

S/11.6 boph 5 hrs 500 mcfg CO

90/4157-72 S/51 bo 1 hr

Comp F/243 bopd

**COMPLETED**

County Morton Elev. \_\_\_\_\_  
 Sec. 20 Twp. 34S Rge. 43W  
 Company Huber  
 Farm Name Interstate (Block "A") No. 3

TOPS	DEPTH	LOG	DATUM	Loc. in Sec.
Anh.				C NW SE
Tp.				PEPL - FO
H.				
Tr.				
Dg.				
Bl.				
L.				Geol. _____
K.C.				Contr. _____
B.K.C.				
Ce.				Co. tools _____
C.				
M.				Pool _____
M.				Interstate
K.				
Mz.				
Ma.				
V.				
S.				
S.				
A				FIRST REPORT
R.				
Pe.				
G.				
T.D.				

Date Comm. 9-17-55 SEP 21 1955  
13" 80 w/100; 8" 1100 w/700; D 2475

*Handwritten signature/initials*

Co.  
Lse.  
No.  
Sec.  
T.  
R.

SEP 27 1955

Scout Cards	<i>mm</i>
Land Small Map	
Land Wall Map	
Tracings	
France Map	
Pierce Map	
Misc.	

County Morton Elev. 3482  
 Sec. 20 Twp. 34 Rge. 43W  
 Company Hiber Corp.  
 Farm Name Interstate (Block H) No. 3

Co.

TOPS	DEPTH	LOG	DATUM
Anh.			
Tp.		2670	
H.			
Tr.			
Dg.			
Bl.			
L.	2898	2902	
K.C. Morrow	4057	4052	570
B.K.C. 1st sd	4105	4107	625
Ce. 2nd sd	4113		631
C. Purdy	4151		669
M. Purdy sd	4232		750
M.			
K.			
Mz.			
Mq.			
V.			
S.			
S.			
A.			
R.			
PE. <i>2</i>			
G.			
T.D.	4260	4259 1/2	

Loc. in Sec. C NW SE  
 Geol. \_\_\_\_\_  
 Contr. \_\_\_\_\_  
 Co. tools \_\_\_\_\_  
 Pool Interstate

Loc.

COMPLETE		
		0

No.

Date Comm. 9-17-55 OCT 26 1955

Sec.

13" @ 80/100 8" @ 1100/700

DST 1100-20 open 1 hr. gas in 13 min.

60 mcfg 120' vsocm 450' so & gcsw

975/20" DST 1147-88 open 55 min.

gas in 5 min. 375 mcfg F/ oil in 47 min.

rec. 990' clean oil 90' sw 1125/20"

5 1/2" @ 1219/600 CO to 1181 2 1/2 / 1172-76

S/ 11.6" boph 5 hr. 500 mcfg CO

T.

R.

OVER

NOV 7 1955

Scout Cards	_____
Land Small Map	_____
Land Wall Map	_____
Tracings	_____
France Map	_____
Pierce Map	_____
Misc.	_____

90/4157-72 S/51 bo 1 hr.  
Comp. #/213 board