

Morton


KANSAS

SECTION 20 TOWNSHIP 34 RANGE 43 W

WELL NO. #10 Interstate Block "A"

COMPANY J. M. Huber

NORTH

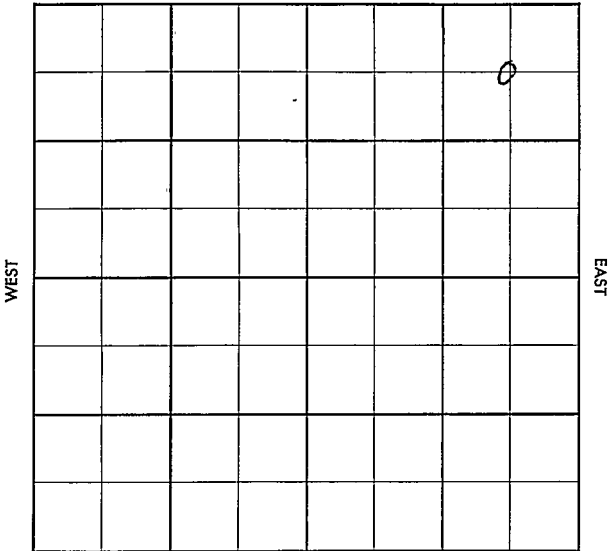

SOUTH

Morton

KANSAS

SEC.	TWP.	R.
20	34	43W

WELL NO.

#10 Interstate Block "A"

FARM

COMPANY

J.M. Huber

CONTRACTOR

Co. tools

Interstate


Ft. from N. Line

Ft. from S. Line

Ft. from E. Line

Ft. from W. Line

C NE NE

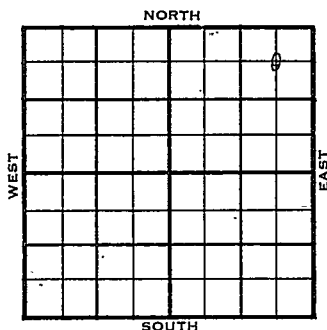

1955

ELEVATION

3848

REPORT

11-30

Location

1956

1-25

Comm. 12-21-55

8 5/8" @ 1119/600

DST ~~4130~~ 4130-46 op 22 min. gas in 1 1/2 min., 2,740 mcfg in 4 min., 3,300 mcfg in 20 min., oil in 22 min., rec 305' oil, 1280/20"

5 1/2" @ 4224, 20/ 4170-75, 176 bo 8 hrs.

20/ 4165-70,

F/ 21 boph, 3 1/2 hrs.

Comp. BHB F/- 1184 bopd

Tp. 2670- 2667

L. 2901 - 2898

Mw. sh. # 4054 4053

Purdy 4133 4134

B. Purdy 4175

TD 4224'

COMPLETED

County Monton Elev. _____
 Sec. 20 Twp. 34 Rge. 43W
 Company J. N. Huber
 Farm Name Interstate Block "A" No. 10

TOPS	DEPTH	LOG	DATUM
Anh.			
Tr.			
H.			
Tr.			
Dg.			
BL.			
L.			
K.C.			
B.K.C.			
Ce.			
C.			
M.			
M.			
K.			
Mz.			
Ma.			
V.			
S.			
S.			
A.			
R.			
PE.			
G.			
T.D.			

Loc. in Sec. _____

C NE NE

Geol. _____

Contr. _____

Co. tools

Pool _____

Interstate

			b
	NOV 30 '55		

FIRST REPORT

Date Comm. _____

Location

Co.

Lse.

No.

Sec.

T.

R.

34

County Morton Elev. 3484
 Sec. 20 Twp. 34 Rge. 4 3W
 Company J. M. Huber
 Farm Name Interstate Block "A" No. 10

TOPS	DEPTH	LOG	DATUM
Anh.			
Tp.	<u>2670</u>	<u>2667</u>	
H.			
Tr.			
Dg.			
BL.			
L.	<u>2901</u>	<u>2898</u>	
K.C.			
B.K.C.			
Ce.			
C.			
M. <u>Man. sh</u>	<u>4054</u>	<u>4053</u>	<u>569</u>
M. <u>Purdy</u>	<u>4133</u>	<u>4134</u>	<u>650</u>
K. <u>B. " f</u>		<u>4175</u>	<u>691</u>
Mz.			
Mq.			
V.			
S.			
S.			
A.			
R.			
PE.			
G.			
TD.	<u>4224</u>		

Loc. in Sec. _____

C NE NE

Geol. _____

Contr. _____

Co. tools

Pool

Interstate

COMPLETE

Date Comm. 12-21-55

JAN 2 5 1956

8 5/8" @ 1119/600 DST 4130-46

open 22 min. gas in 1 1/2 min.

2,740 mcfg in 4 min. 3,300 mcfg in

20 min. oil in 22 min. rec. 305' oil

1280/20" 5 1/2" @ 4224 CO

20/ 4170-75 176 bo 8 hr.

20/ 4165-70 F/ 21 boph 3 1/2 hr.

Comp. BHB F/ 1184 bopd