

Morton


KANSAS

SECTION 20 TOWNSHIP 34 RANGE 43 W

WELL NO. #5 Interstate Block "A"

COMPANY Huber Corp.

NORTH

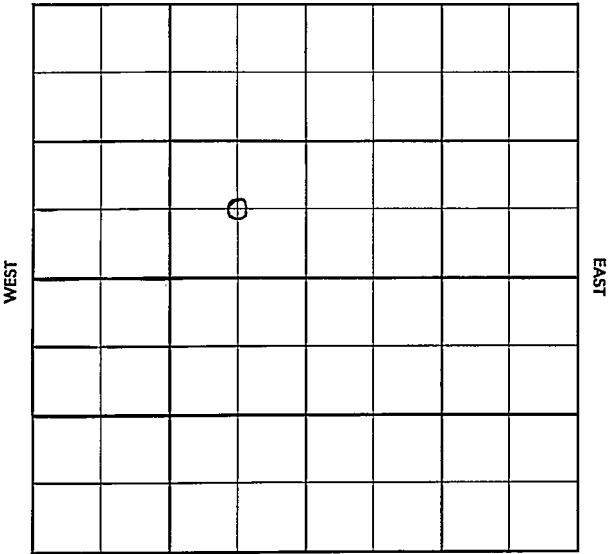

SOUTH

Morton

KANSAS

SEC.	TWP.	R.
20	34	43W

WELL NO.

#5 Interstate Block "A"

FARM

COMPANY

Huber Corp

CONTRACTOR

Co. Tools
Interstate


_____ Ft. from N. Line

_____ Ft. from S. Line

_____ Ft. from E. Line

_____ Ft. from W. Line

C SE NW:

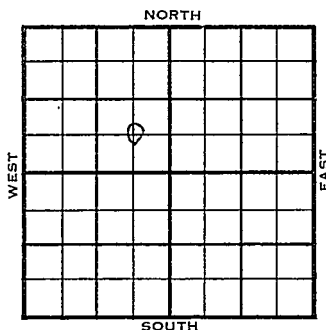

PEPL - FO

	ELEVATION	REPORT
1955	3503	
10/19	Comm 10-17-55 13" @ 75/100 Drlg 150	
12-7	8" @ 1193/600 DST 4168-4210 op 40 min. gas in 2 min. 1500 mcfg in 3 min. sp. oil in 6 min 3 to 4 mcfg, rec 420' oil 1250/30" DST 4438-70 op 1 hr. rec. 15' mud 100/20" DST 4467- 4500 op 1 hr. gas in 30 min. rec. 50' sgcm, 900/20" DST 4500-52 op 65 min. gas in 55 min. rec. 300' sgcm, 1900' sw, 1035/30" 5 1/2" @ 4300/600 CO to 4260, 16/ 4193-97 S/ dry, 28/ 4191-98, S/ 6 gwph, 28/ 4191-98 S/ 6 gwph, 250 A, S/ 20 bo 3 bw Comp. 140 bopd Tp. 2693-2693 L: 2920-2922 Mw Sh. 4072 Mw. Sd. 4135 Purdy Sd 4170 B. Purdy 4200 Sd. 4260-65 Keyes 4475 TD 4552	

COMPLETED

County Morton Elev. _____
 Sec. 20 Twp. 31 Rge. 13W
 Company Hiber Corp.
 FarmName Interstate Block "A" No. 5

TOPS	DEPTH	LOG	DATUM
Anh.			
Ip.			
H.			
Tr.			
Dg.			
Bl.			
L.			
K.C.			
B.K.C.			
Ce.			
C.			
M.			
M.			
K.			
Mz.			
Ma.			
V.			
S.			
S.			
A.			
R.			
Pe.			
G.			
T.D.			

Loc. in Sec. C SE NW
 Geol. _____
 Contr. _____
 Pool Co. tools
Interstate

FIRST REPORT
 OCT 19 1955

Date Comm. 10-17-55 FEPL - FO
13" @ 75/100 drlg. 150

34

Co.
Lse.
No.
Sec.
T.
R.

OCT 25 1955

Scout Cards	<u>mm^c</u>
Land Small Map	_____
Land Wall Map	_____
Tracings	_____
France Map	_____
Pierce Map	_____
Misc.	_____

County Moxtton Elev. 3503
 Sec. 20 Twp. 34 Rge. 43W
 Company Huber Corp.
 Farm Name Interstate Block "A" No. 5

TOPS	DEPTH	LOG	DATUM	Loc. in Sec.
Anh.				C SE NW
Tp.	<u>2693</u>	<u>2693</u>		
H.				
Tr.				
Dg.				
BL.				
L.	<u>2920</u>	<u>2922</u>		
K.C. <u>Mush</u>		<u>4072</u>	<u>569</u>	Geol.
B.K.C. " <u>sd</u>		<u>4135</u>	<u>632</u>	Contr.
Ge. <u>Purdy sd</u>		<u>4170</u>	<u>667</u>	Co. tools
SB. <u>Purdy</u>		<u>4200</u>	<u>697</u>	
M.				Pool
W. <u>sd</u>	<u>4260-65</u>	<u>757</u>		Interstate
K. <u>16"</u>				
Mz. <u>Keyes</u>		<u>4475</u>	<u>972</u>	
Ma.				
V.				
S.				
S.				
A.				
R.				
PE.				
G.				
TD.	<u>4552</u>			

COMPLETED

Date Comm. 10-17-55 DEC 7, 1955

8" @ 1193/600 DST 4168-4210 open 40 min.

gas in 2 min. 1,500 mcfg in 3 min.

sp. oil in 6 min. 3 to 4 mcfg Rec.

120' oil 1250/30" DST 4438-70 open

1 hr. rec. 15' mud 100/20" DST 4467-

4500 open 1 hr. gas in 30 min.

rec. 50' sgcm 900/20" - DST 4500-52

open 65 min. gas in 55 min. rec. 300'

DEC 15 1955

R. G.

Comp. 1710 popd

250 A S / 20 bo 3 #w

98 S / 6 #wph 28 / 1191-98 S / 6-#wph

GO to 1260 16 / 1193-97 S / dry 28 / 1191-

52m 1900! SM 1035/30" 5 1/2" @ 1300/600