


Form 51-5M-2-29-34703
Map No. *Morton* **KANSAS** Sec. *28* Twp. *34* R. *39^W*
Well No. *1-* *North* Farm
Argus Gas Company
NORTH

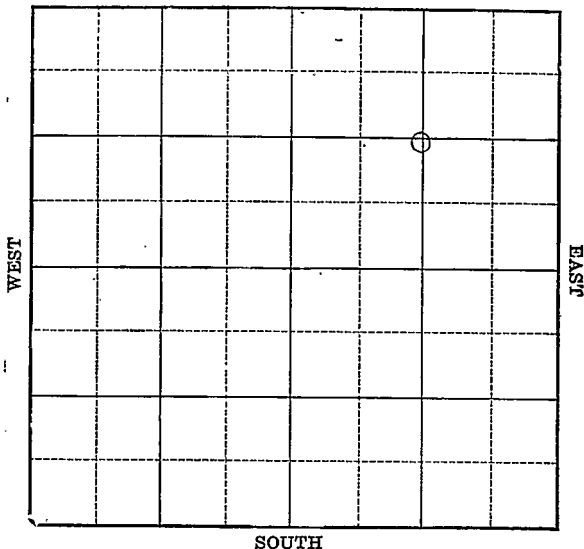

Location _____
Drilling Remarks _____

RECORD

Cased _____ in. _____ ft.
Sand _____
Gas _____
Oil _____
Total Depth _____

Rig Up _____
Drilling Remarks _____

PRODUCTION

1st 24 hrs. Nat. _____
1st 24 hrs. after shot _____
Gas _____ cu. ft.
Dry Hole _____
Abandoned _____


Morton
 Map No. KANSAS Sec. 20 Twp. 34 R. 39^w
 Well No. 1- North Farm
Argus Gas Company

1320 Ft. from N. Line

 Ft. from S. Line

1320 Ft. from E. Line

1930 Ft. from W. Line

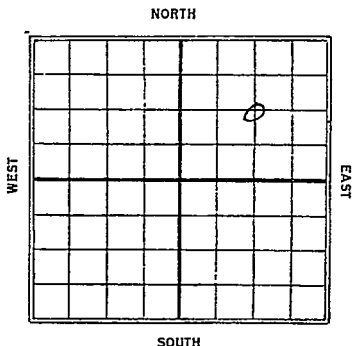

Date	REPORT
4/30	Loc.
5/7	
5/14	Rigging up
5/21	hldg. 1564'
5/28	" 1400'
6/4	" 1535'
6/11	" 1570'
6/18	" 1804'
6/25	Cement case 1804'
7/2	hldg. 2468'
7/9	Crust 2500'
7/16	hldg. 2640'
7/23	Sand 2640 - 2850
	TD 2850
	7 ft gas
	Comp.





J Contractor

SECTION PLAT

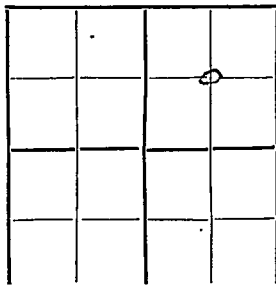

1820 Ft. from N. Line

_____ Ft. from S. Line

1820 Ft. from E. Line

_____ Ft. from W. Line

FIRST REPORTS

Location ✓

Rig up _____

Drilling and Remarks: _____

RECORD

Cased _____ in., _____ ft.

Sand _____

Gas _____

Oil _____

Total Depth _____

PRODUCTION

1st 24 hrs. Nat. _____

1st 24 hrs. after shot _____

Gas _____ Cu. Ft.

Dry Hole _____

Abandoned _____

Date _____

APR 30 1930

192

S. J. LEWIS

Scout

Map No. **KANSAS** Sec. 20 Twp. 34 R. 39W

Well No. 1 Dr. Th.

Argus Gas Company

Contractor

SECTION PLAT


1320 Ft. from N. Line

_____ Ft. from S. Line

1320 Ft. from E. Line

_____ Ft. from W. Line

COMPLETED

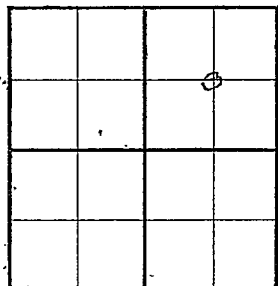

Location _____

Rig up _____

Drilling and Remarks:

7M Gas

RECORD

Cased _____ in., _____ ft.

Sand 2140 - 2850

Gas _____

Oil _____

Total Depth 2850

PRODUCTION

1st 24 hrs. Nat. _____

1st 24 hrs. after shot _____

Gas _____ Cu. Ft.

Dry Hole _____

Abandoned _____

Date

JUL 23 1930

19

S. J. LEWIS

Scout