


Section 20 Township 34 Range 40W

Well No. #1 Miller "M"

Company Cities Service

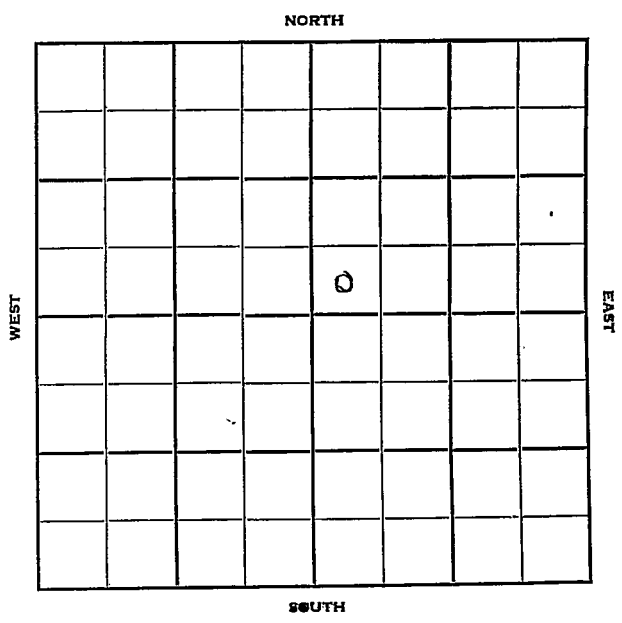

Morton

KANSAS

Sec. 20 Twp. 34 R. 40W

Well No. #1 Miller "M" Farm

Citiss Service Company

Hugoton Pool Contractor


Ft. from N. Line

225' Ft. from S. Line

Ft. from E. Line

225' Ft. from W. Line

SW NE

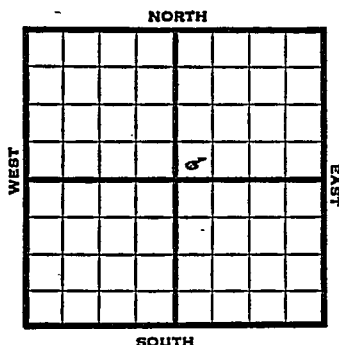

1951 Elev. 3384' REPORT

5/16 Location

8/15 Spud 5-23-51
Gas Well TD 2645
8" @ 443
Her. 2436' Krider 2462
Win 2534 Ft. Riley 2608
5" @ 2644
TD 2645 CO to 2624
60/2608-20 4000 A
60/2560-72 100/2532-52
60/2498-2510 30/2482-88
40/2470-78 30/2462-68
2100 A Comp. 13,700,000 gas
417#

COMPLETED

J. E. TYRA

J. E. TYRA