

Morton


KANSAS

SECTION 20 TOWNSHIP 34 RANGE 43 W

WELL NO. #3 Humble

COMPANY Huber

NORTH

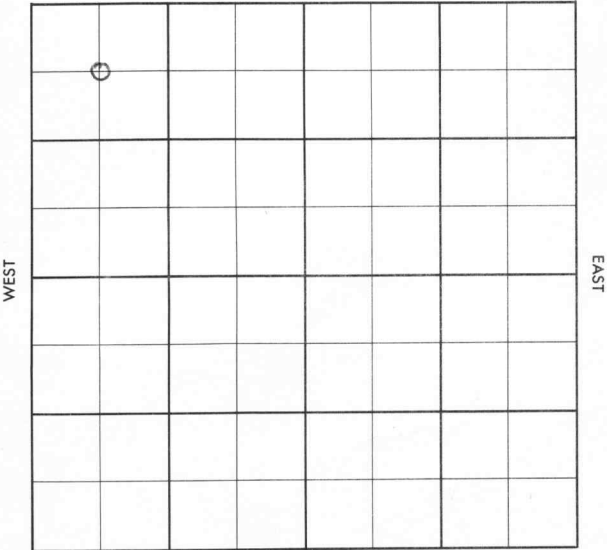

SOUTH

Morton

KANSAS

SEC.	TWP.	R.
20	34	43W

WELL NO.

#3 Humble

FARM

COMPANY

Huber

CONTRACTOR

Co. Tools

Interstate


Ft. from N. Line

Ft. from S. Line

Ft. from E. Line

Ft. from W. Line

C NW NW

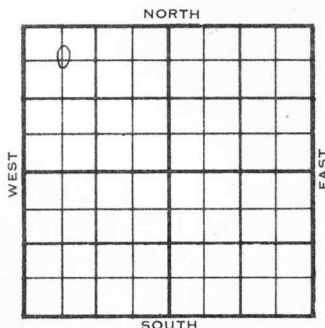

1956

ELEVATION

3516

REPORT

1-25

Location

4-11

Comm. 1-29-56

13" @ 80 w/100

8 5/8" @ 1119 w/600

5 1/2" @ 4264

CO to 4230, 12/ 4209-12,

SI 12 hrs.

F/ 5 boph, 5 hrs.

40/ 4199-4209

Comp. 130 bopd

Tp. 2704

L. 2934

Mw. sh. 4096

Purdy sd 4200

B. Purdy 4212

TD 4265

COMPLETED

County Morton Elev. 3516 Co.
 Sec. 20 Twp. 34 Rge. 43W
 Company Huber Corp.
 Farm Name Humble No. 3

TOPS	DEPTH	LOG	DATUM	Loc. in Sec.
Anh.				C NW NW
Tp.		2704		
H.				
Tr.				
Dg.				
Bl.				
L.		2934		Geol.
K.C.Mw Sh	4096	2934	580	Contr.
B.K.C. Purdy sd		4200	684	Co. tools
Ce. B. Purdy		4212	696	Pool
C.				Interstate
M.				
M.				
K.				
Mz.				
Me.				
V.				
S.				
S.				
A.				
R.				
Pt.				
G.				
T.D.	4265			

Date Comm. 1-29-56 APR 1 1 1956

13" @ 80/100 8 5/8" @ 1119/600

5 1/2" @ 4264 CO to 4230 12/ 4209-12

SI 12 hr. F/ 5 boph 5 hr.

40/ 4199-4209 Comp. 130 bopd

County Morton Elev. _____
 Sec. 20 Twp. 34 Rge. 43W
 Company Huber
 Farm Name Humble No. 3

TOPS	DEPTH	LOG	DATUM
Anh.			
TP.			
H.			
Tr.			
Dg.			
BL.			
L.			
K.C.			
B.K.C.			
Ce.			
C.			
M.			
M.			
K.			
Mz.			
Mq.			
V.			
S.			
S.			
A.			
R.			
PE.			
G.			
T.D.			

Loc. in Sec. _____

C NW NW

Geol. _____

Contr. _____

Co. tools

Pool _____

Interstate

0		
JAN 25 '56		
FIRST REPORT		

Date Comm. _____

Location

34