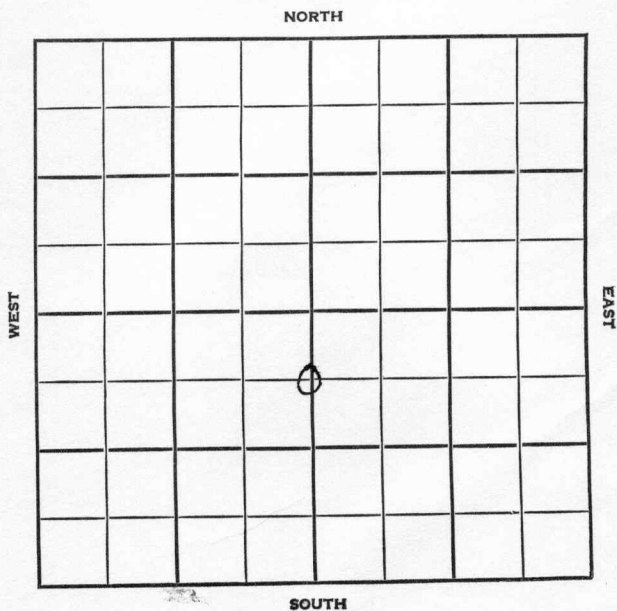


Section 20 Township 34 Range 43 WWell No. #1 InterstateCompany Panhandle Eastern

Morton

KANSAS

SEC.	TWP.	R.
20	34	43W

WELL NO.

#1 Interstate

FARM

COMPANY

Panhandle Eastern

CONTRACTOR

Interstate

Ft. from N. Line


1890

Ft. from S. Line

Ft. from E. Line

2590

Ft. from W. Line

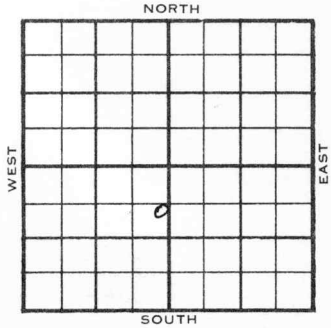C N $\frac{1}{2}$ S1/2 Sec

1955	ELEVATION 3477	REPORT
------	-------------------	--------

10/12

Loc

10/26

Aband Loc

ABANDONED

County **Morton** Elev. **3477**
 Sec. **20** Twp. **34** Rge. **43W**
 Company **Panhandle Eastern**
 Farm Name **Interstate** No. **1**

TOPS	DEPTH	LOG	DATUM	Loc. in Sec.
Anh.				C N $\frac{1}{2}$ S $\frac{1}{2}$ Sec.
Tr.				1890' SL
Dg.				2590' WL
Bl.				Geol.
L.				Contr.
K.C.				Pool
B.K.C.				Interstate
Ce.				FIRST REPORT OCT 12 '55
C.				
M.				
M.				
K.				
Mz.				
Me.				
V.				
S.				
S.				
A.				
R.				
Pe.				
G.				
T.D.				

Date Comm.

Location

34

