
DX 78-1

Sumner KANSAS

Section 21 Township 34 Range 3 W

Well No. #1 Subera

Company Falcon-Seaboard

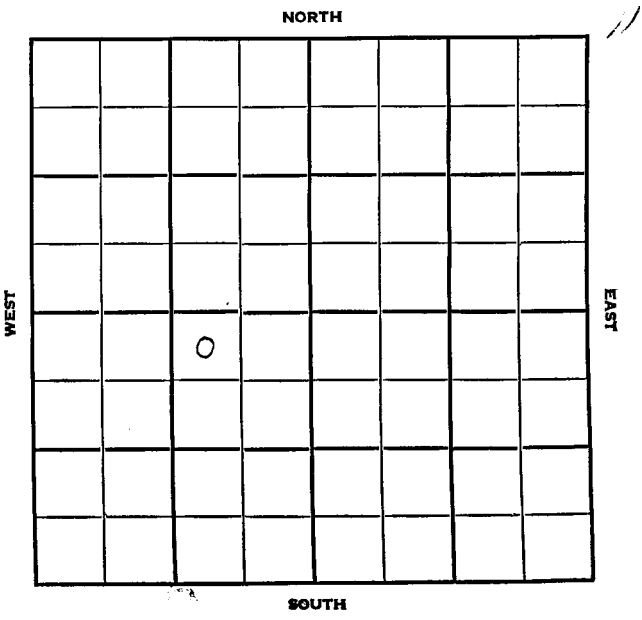

Sumner KANSAS

SEC.	TWP.	R.
21	34	3W

WELL NO.

#1 Subera FARM

COMPANY

Falcon-Seaboard

CONTRACTOR

WILDCAT


_____ Ft. from N. Line

_____ Ft. from S. Line

_____ Ft. from E. Line

_____ Ft. from W. Line

NW NE SW

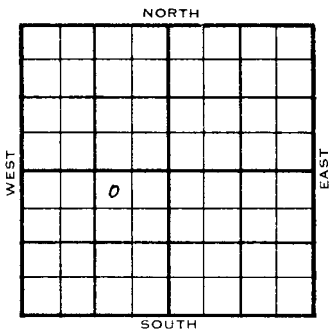

1955 ELEVATION 1182' REPORT

9-14 Comm. 9-8-55
9" @ 606/400
Drlg. 2365'

10/19 Comm 9-8-55
9" @ 606/400

Stal	3198	3196
KC	3553	3560
Chat	4317	4320
K		4677
Chatta	4717	
Woodford	4736	
Mz	4745	4744
Viola	4764	4756
Sd	4775	4764
TD	4788	4788

DST 4318-27 open 1 hr Rec 75' sgcm
DST 4325-41 open 2 hr Rec 135' sgcm 140/15" DST 4749-65 open 2 hr rec 340' msw 1720/20"
D & A

ABANDONED

DX-78

FORM 513 REV. SUNRAY

County Sumner Elev. 1182

Sec. 21 Twp. 34 Rge. 3W

Company Falcon-Seaboard

Farm Name Subera No. 1


TOPS	DEPTH	LOG	DATUM
Anh. Stal	3148	3196	2014
Tp.			
H.			
Tr.			
Dg.			
Bl.			
L.			
K.C.	3553	3560	3378
B.K.C.			
Ce.			
C.			
M. [illegible]	4317	4320	3138
M.			
K.		4677	3495
Mz. [illegible]	4111		3555
Mc. [illegible]	4156		3554
W. [illegible]	4145		3562
S. [illegible]	4764	4146	3574
S.	4775	4767	3585
A			
R.			
P€.			
G.			
T.D.	4[illegible]	4782	

Loc. in Sec. NW NE SW

Geol.

Contr.

Pool Wildcat

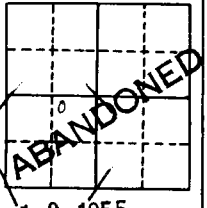

Date Comm. 9-8-55

OCT 19 1955

9" @ 606/400 DST 4318-27 open 1 hr.
Rec. 75' sgcm DST 4325-41 open 2 hr.
Rec. 135' sgcm 140/15" DST 4749-65
open 2 hr. rec. 340' msw 1720/20"
D & A

FORM 513 REV. SUNRAY

County ~~Sumner~~ Elev. 1182

Sec. 21 Twp. 31 Rge. 3W

Company Falcon-Seaboard

Farm Name Subera No. 1

TOPS	DEPTH	LOG	DATUM
Anh.			
Tp.			
H.			
Tr.			
Dg.			
Bl.			
L.			
K.C.			
B.K.C.			
Ce.			
C.			
M.			
M.			
K.			
Mz.			
Mo.			
V.			
S.			
S.			
A			
R.			
P€.			
G.			
T.D.			

Loc. in Sec. NW NE SW

Geol.

Contr.

Pool Wildcat



Date Comm. 9-8-55

9" @ 606/1400 drlg. 2365