

21

34

5 W

Section \_\_\_\_\_ Township \_\_\_\_\_ Range \_\_\_\_\_

# 1 L. R. Bird

Well No. \_\_\_\_\_

Texas Company

Company \_\_\_\_\_

NORTH

				0			

WEST

EAST

SOUTH

\*

Sec. 21 Twp. 34 R. 5 W

Well No. # 1 L. R. Bird Farm

Texas Company Company

Stickle Drlg. Contractor

Wildcat


330 Ft. from N. Line

\_\_\_\_\_ Ft. from S. Line

\_\_\_\_\_ Ft. from E. Line

330 Ft. from W. Line

NW NW SE

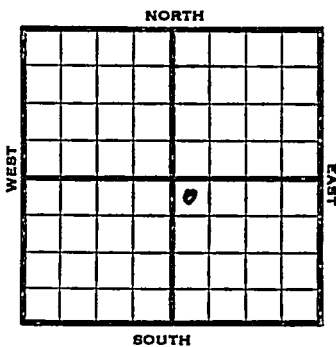

1953 Elev. 1219' REPORT

8/5 Spud 8-1-53  
10-3/4" @ 600 WOC

8/12 WOD

8/19 Top 2654, Doug 3187,  
DST 3185-3200 1 hr, 10' M 15#  
Stal 3542, Lay 3860, KC 3878  
DST 3850-70 1 hr, 30' M, 1478#  
Drlg 4094'

8/26 Spud 8-1-53  
D & A  
TD 4596'  
10-3/4" @ 600'  
Top. 2654', Doug 3187',  
DST 3185'-3200' opn 1 hr, rec 10' mud  
15# Stal. 3542', Layton 3860', KC  
3878'  
DST 3850'-70' opn 1 hr, rec 30' mud  
1478# Miss 4578'  
TD 4596'  
D & A

**ABANDONED**



