


DX 78-1

Barber KANSAS

Section 21 Township 34 Range 11 W

Well No. # 1 Landis

Company Purcell & Mull

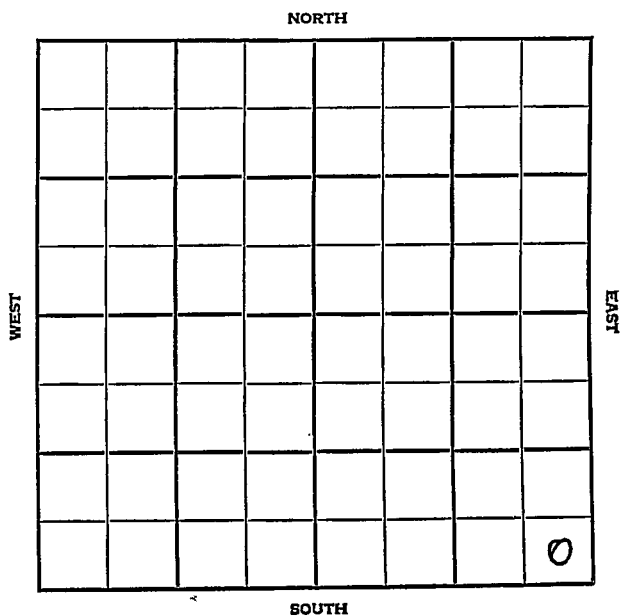

Barber

KANSAS

SEC.	TWP.	R.
21	34	11W

WELL NO. #1 Landis FARM

COMPANY Purcell & Mull

CONTRACTOR Co. Tools.


Wildcat.

_____ Ft. from N. Line
330

_____ Ft. from S. Line
330

_____ Ft. from E. Line

_____ Ft. from W. Line

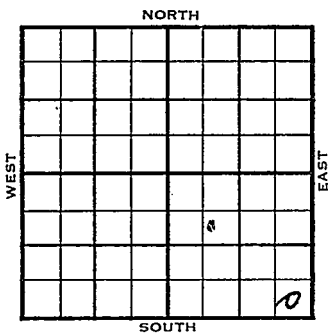

SE SE SE
NCRA F/O Aurora - DHM

1955	ELEVATION	REPORT
------	-----------	--------

2/23	Fsg.	
------	------	--

