


Section 21 Township 34 Range 33-W

Well No. #1 Bruns

Company Cities Service

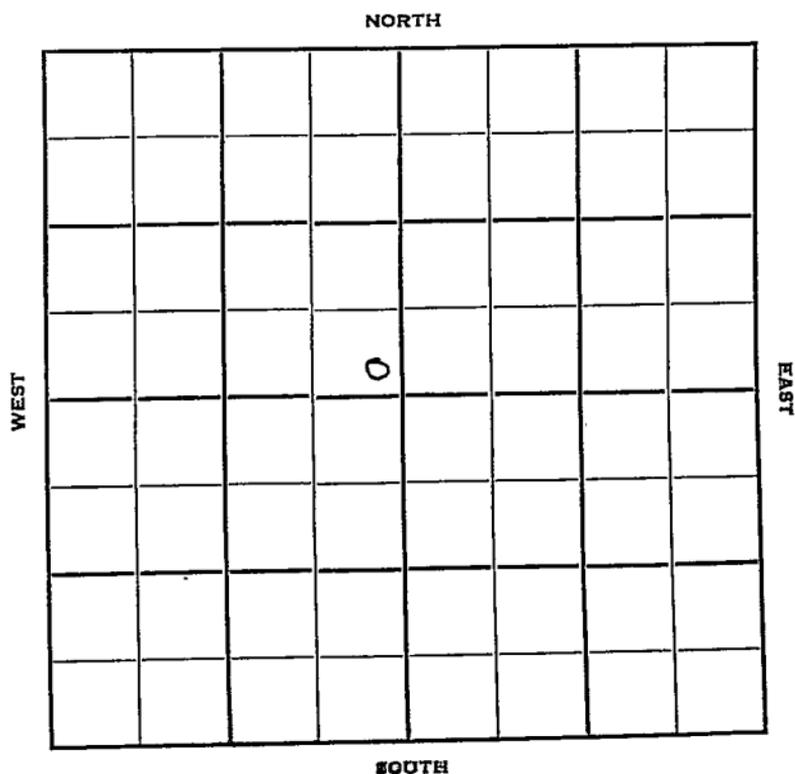

Sec. 21 Twp. 34 R. 33W

Well No. #1 Bruns Farm _____

Cities Service Company _____

Contractor Hugoton Pool

_____ Ft. from N. Line

100'


_____ Ft. from S. Line

100'

_____ Ft. from E. Line

_____ Ft. from W. Line

SE NW

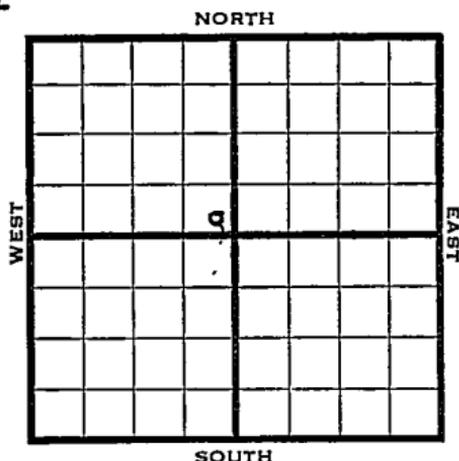

1950

Elev 2849

REPORT

8/9

Location

10/18

Spud 8-7-50

8" @ 720

5" @ 2764

TD 2765

Her 2586

Krider 2621

Win 2706

30/2691-97, 160/2654-86, 40/2622-30

140/2654-83, 40/2622-30, 60/2680-86

12/2680-82, 48/2682-86

PB 2679

Comp 2,420,000 gas

open flow

Completed

COMPLFTED

County Seward State KansasSec. 21 (Blk.) 34 (Sur.) 33W Map No.Operator Cities ServiceWell No. 1 Farm BrunsElev. 2849 Location SE NW

100 Ft. From S Line NW100 Ft. From E Line Quarter1st. ReportCompletion OCT 18 1950Remarks Hugoton PoolSpudding Date 8-7-50Drlg. Data Gas well TD 27658" @ 720 5" @ 2764 TD 2765Her. 2586 Krider 2621 Win. 270630/ 2691-97 160/ 2654-86 40/ 2622-30140/ 2654-82 40/ 2622-30 60/ 2680-8612/ 2680-82 48/ 2682-86 PB 2679Comp. 2,420,000 gas open flow

J. E. TYRA