

KANSAS


FORM 51 25M 3-49 PETROL

Seward

Section 21 Township 34 Range 34-W

Well No. #1 Hacker

Company Plains Natural

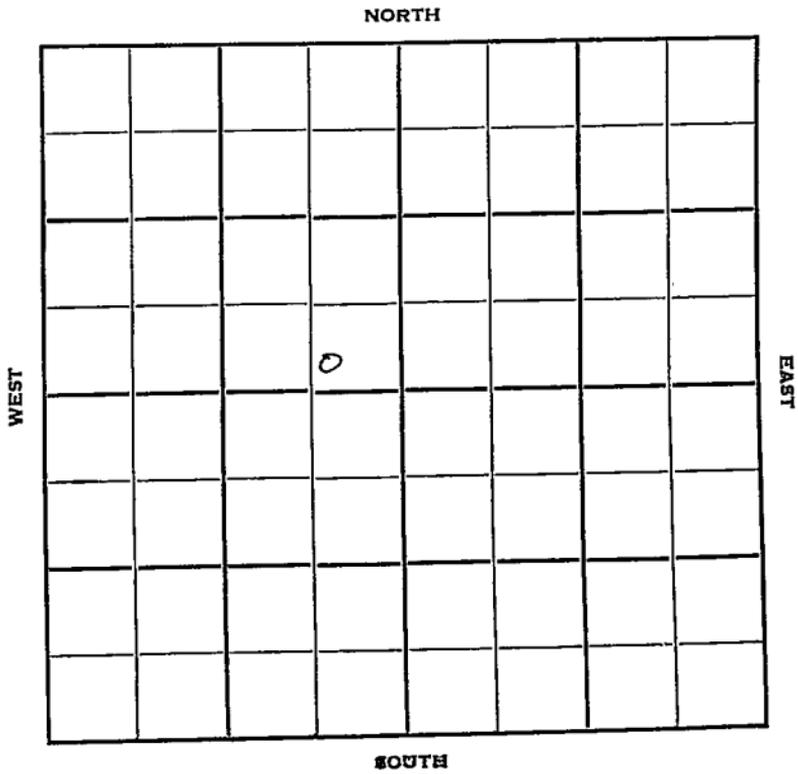

Sec. 21 Twp. 34 R. 34W

Well No. #1 Hacker Farm

Plains Natural Company

Contractor

Hugoton Pool


Ft. from N. Line

200' Ft. from S. Line

600' Ft. from E. Line

Ft. from W. Line

SE NW

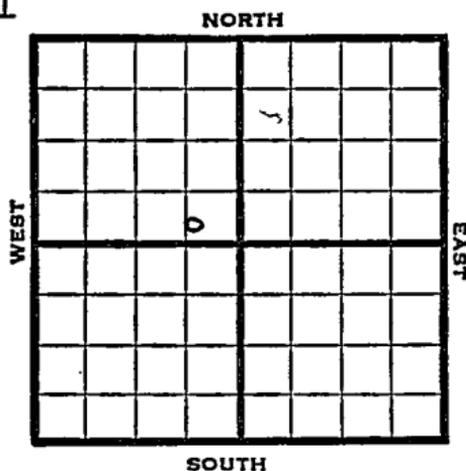

1950

Elev 2949

REPORT

9/20

Location

10/18

Spud 9-23-50
 10" @ 688
 7" @ 2770
 T_u 2772
 270/2705-50, 60/2680-90, 60/2655-65
 30/3647-52
 Hol 2586 Her 2646
 Krider 2679 Win 2758
 42/2760-67
 17000 total acid
 Comp 9,449,000 gas
 412#
 Completed

COMPLETED

County Seward State Kansas

Sec. 21 (Blk. 34) (Sur. 34W) Map No.

Operator Plains Natural

Well No. 1 Farm Hacker

Elev. 2949 Location SE NW

		0			

200 Ft. From S Line NW

600 Ft. From E Line Quarter

1st. Report

Completion OCT 18 1950

Remarks Hugoton Pool

Spudding Date 9-23-50

Drlg. Data Gas well TD 2772

10" @ 688 7" @ 2770 TD 2772

270/ 2705-50 60/ 2680-90 60/ 2655-65

30/ 2647-52 Hol. 2586 Her. 2646

Krider 2679 Win. 2758 42/ 2760-67

17000 total acid Comp. 9,449,000 gas
412#

J. E. TYRA