


KANSAS Stevens

Section 21 Township 34 Range 35W

Well No. 1 Stockstill

Company Cities Service Gas
Hugoton

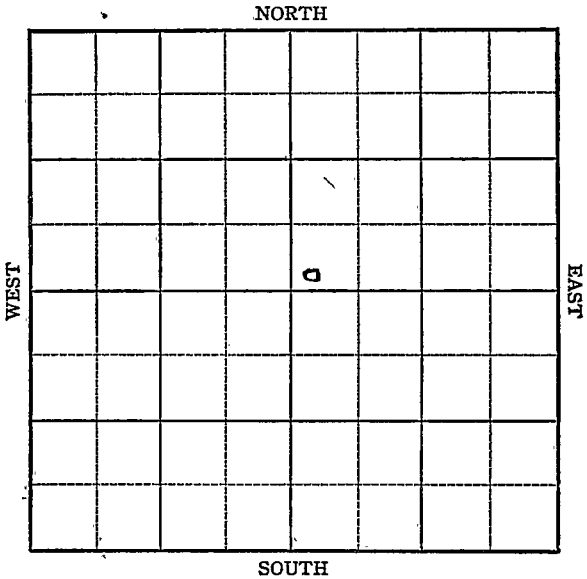

KANSAS

Stevens

Sec. 21 Twp. 34 R. 35W ✓

Well No. #1 Stockstill Farm

Cities Service Gas Company

Hugoton Pool (McGill, Cont.)

NORTH

 Ft. from N. Line


150'

 Ft. from S. Line

 Ft. from E. Line

100' Ft. from W. Line

SW NE

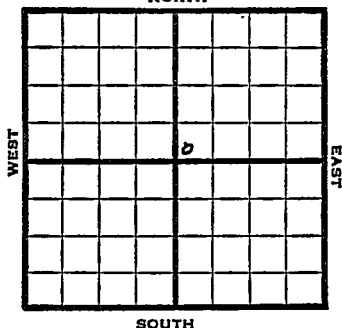

1949

Elev 3012'

R E P O R T

5/25

RUR

6/1

8" @ 771'
Drig. 2175'

6/7

TD 2710
7"@ 2695'

6/15

TD 2823'
163' of 5" Perf Liner
15,000 acid

6/21

"

6/29

TD 2823'
7"@ 2659'
163' of 5" Perf Liner @ 2823'
19000 Acid
19,667,000 Gas
412# R Pr.
Comp

COMPLETED

Kansas

Hugoton Pool

Map No. _____ Sec. 21 Twp. 34 R. 35WWell No. 1 Stockstill

Cities Service Gas

Company

McGill

~~FIRST REPORT~~ Contractor

SW NE

SECTION PLAT

_____ Ft. from N. Line

150 Ft. from S. Line

_____ Ft. from E. Line

100 Ft. from W. Line

		6	

Stevens County

Location _____

Rig up _____

Drilling and Remarks:

R U R

RECORD

Cased _____ in., _____ ft.

Sand _____

Gas _____

Oil _____

Total Depth _____

PRODUCTION

1st 24 hrs. Nat. _____

1st 24 hrs. after shot _____

Gas _____ Cu. Ft.

Dry Hole _____

Abandoned _____

Date


MAY 25 1949

19

S. J. LEWIS

Scout

EAST IN FRONT

 

Scout Cards	✓
Land Small Map	✓
Land Wall Map	✓
Tracing	✓
France Map	✓
Pierce Map	✓
Misc.	✓

Map No. 1 Sec. 21 Twp. 34 R. 35W

Well No. 1 Stockstill

Cities Service Gas Company

COMPLETE

Contractor

SW NE


E 13012
SECTION PLAT

150 Ft. from N. Line

100 Ft. from S. Line

100 Ft. from E. Line

100 Ft. from W. Line

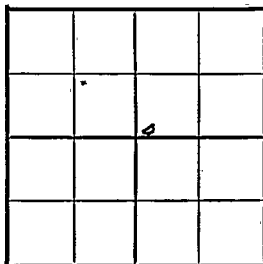

Stevens County

Location

Rig up

Drilling and Remarks:

2" C 2695

163' of 5" Bay liner

C 2523

19000 acid

19,667,000 Gall

4 1/2" R/A

RECORD

Cased in., ft.

Sand

Gas

Oil

Total Depth 2523

PRODUCTION

1st 24 hrs. Nat.

1st 24 hrs. after shot

Gas Cu. Ft.

Dry Hole

Abandoned

Date

JUN 29 1949

S. J. LEWIS Scout

Scout Cards *Edith*
Land Small Map *Edith*
Land Wall Map *Edith*
Tracings *Edith*
France Map *Edith*
Pierce Map *Edith*
Misc. *Edith*