

Morton


KANSAS

SECTION 21 TOWNSHIP 34 RANGE 43W

WELL NO. #2 Interstate

COMPANY Panhandle Eastern

NORTH

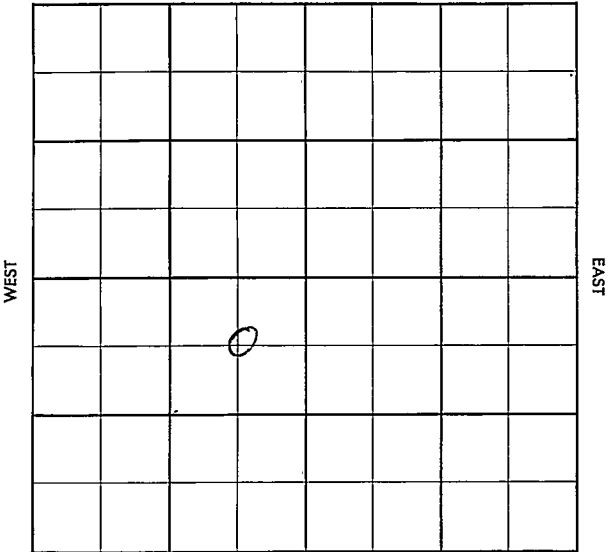

SOUTH

Morton

KANSAS

SEC.

TWP.

R.

21

34

43W

WELL NO.

#2 Interstate

FARM

COMPANY

Panhandle Eastern

CONTRACTOR

Garvey

Interstate


Ft. from N. Line

Ft. from S. Line

Ft. from E. Line

Ft. from W. Line

C NE SW

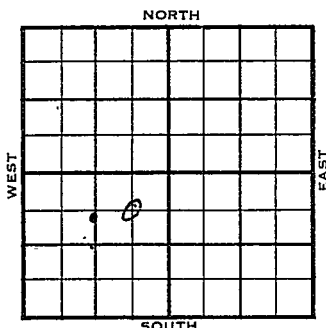

1956

ELEVATION

REPORT

5-9

13" @ 102 w/200

~~#8~~ 8" @ 1243 w/600

Dr1g. 2035

County Morton Elev. _____
 Sec. 27 Twp. 34 Rge. 13W
 Company Panhandle Eastern
 Farm Name Interstate No. 2

TOPS	DEPTH	LOG	DATUM	Loc. in Sec. _____
Anh.				<u>6 NE SW</u>
Tr.				
H.				
Tr.				
Dg.				
Bl.				
L.				Geol. _____
M.C.				Contr. _____
B.K.C.				<u>Garvey</u>
Ce.				
C.				Pool _____
M.				<u>Interstate</u>
M.				
K.				
Mz.				
Ma.				
V.				
S.				
S.				
A.				
R.				
Pe.				
G.				
TD.				

FIRST REPORT	
0	
MAY 9	56

Date Comm. 13" @ 102/200 8" @ 1243/600 drlg. 2035

SEC I YAY

SEC I YAY

County Morton Elev. 3472-
 Sec. 21 Twp. 34 Rge. 13W
 Company Panhandle Eastern
 Farm Name Interstate No. 0-2-2

TOPS	DEPTH	LOG	DATUM	Loc. in Sec.
Anb.				C NE SW
Tr.				
H. <u>1026</u>		<u>2460</u>		
Tr. <u>TP</u>		<u>2655</u>		
Dg.				
BL.				
L.		<u>3102</u>		Geol.
K.C.				
B.M.C.				Contr.
Ce.		<u>3834</u>		<u>Garvey</u>
G. <u>MW</u>		<u>4091</u>		
M. <u>up MW 5d</u>		<u>4136</u>		Pool
M. <u>"G" 5d</u>		<u>4426</u>		<u>Interstate</u>
K. <u>KEYPS</u>		<u>4485</u>		
Mz. <u>MI</u>		<u>4641</u>		
Mq.				
V.				
S.				
S.				
A.				
R.				
PE.				
G.				
TR.	<u>4650</u>			

COMPLETE

OCT 17 '56

Date Comm.

13" @ 102/200 8" @ 1243/600 drlR. 2035

MAY 16 '56 DST 3815-421 hr. res.

90' SCM + 240' MSW BHP

640/20 IP 3925 MAY 23 '56 DST 4023

-55 30" res 10' Md 50/15" DST

4140-65 18" ga 291 MCF in 4"

76 MCF in 6" Mud in 14" oil

in 15" Hole Full oil BHP 1220/20

DST 4300-4345 15" res 5' Md.

FORM 513-1 SUNRAY

21-34-434

CNE 311

All press 0¹ 4616 MAY 29 '56

4 1/2 @ 4248/600 JUN 6 '56

pp10 4182 60/4151-61 CO

Test JUN 13 '56 pf 120/4141-61

FU Nat ra TTA 8/L

ST JUN 20 '56 JUN 27 '56 JUL 3 '56 JUL 11 '56

JUL 18 '56 JUL 25 '56 AUG 1 '56 AUG 8 '56 AUG 15 '56

AUG 22 '56 AUG 29 '56 SEP 5 '56 SEP 12 '56 SEP 19 '56

SEP 26 '56 OCT 3 '56 OCT 10 '56 OCT 17 '56

145 Bopd 38.5° 9raw

CNE 311