


Section 21 Township 34S Range 43W
Well No. # 0-4 Interstate #4
Company P.F.P.I.

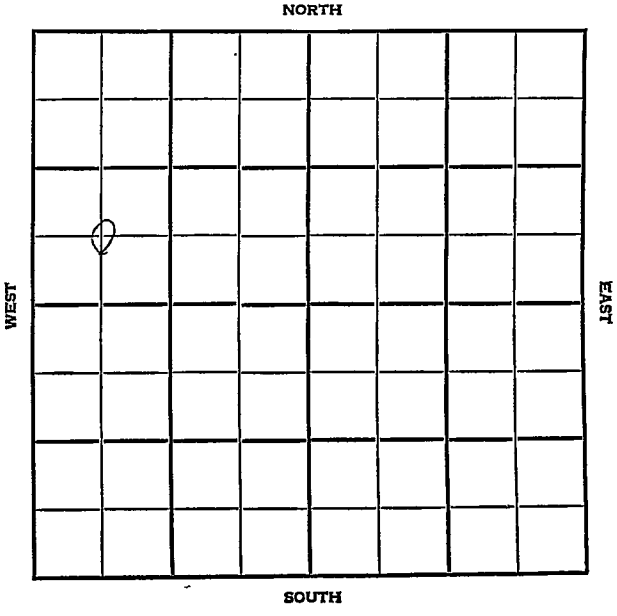

Morton

KANSAS

SEC.	TWP.	R.
21	34S	43W
WELL NO.		


0-11 Interstate FARM COMPANY

P. E. P. L. CONTRACTOR

Nye-Snell

Interstate

_____ FT. FROM N. LINE
_____ FT. FROM S. LINE
_____ FT. FROM E. LINE
_____ FT. FROM W. LINE

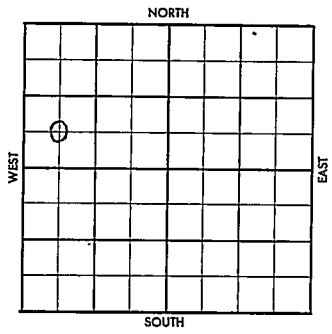

C SW MW

	ELEVATION	REPORT
1956		
6-20		Comm. 6-11-56 10" @ 104 w/ , 7" 1140 w/500 Drlg. 2235'

County Morton

Elev. _____

Sec. 21Twp. 34SRge. 43WCompany P. E. P. L.Farm Name InterstateNo. 4

TOPS

DEPTH

LOG

DATUM

Loc. in Sec. _____

Anh. _____

Tp. _____

H. _____

Tr. _____

Dg. _____

BL. _____

L. _____

K.C. _____

B.K.C. _____

Ce. _____

C. _____

M. _____

M. _____

K. _____

Mz. _____

Mo. _____

V. _____

S. _____

S. _____

A. _____

R. _____

Pe. _____

G. _____

T.D. _____

Geol. _____

Contr. _____

Nye-Snell

Pool _____

Interstate

FIRST		REMO	
0			

Date Comm. 6/11/56

JUN 20 '56

10" 104 W / , 7" 1140 W/500, D 2235

6001 2 2 W

County MortonElev. 9475Sec. 21Twp. 34SRge. 13WCompany P. F. P. L.Farm Name InterstateNo. 04

TOPS	DEPTH	LOG	DATUM
Anb. <u>US26</u>		<u>2458</u>	
Ip.		<u>2654</u>	
H.			
Tr.			
Dg.			
Bl.			
L. <u>(CS6)</u>		<u>2891</u>	
K. <u>CS9</u>		<u>3092</u>	
B.K.C.			
Ce.		<u>3821</u>	
C. <u>MW</u>		<u>4078</u>	
M. <u>Purdy</u>		<u>4121</u>	
N.			
K.			
Mz.			
Me.			
V.			
S.			
S.			
A.			
R.			
PE.			
G.			
TD.	<u>4270</u>		

Loc. in Sec.

C. SW NW

Geol.

Contr. Nye

Spell

Pool

Interstate

		OCT 31 '56
0		
COMPLETE		

Date Comm. 6/11/56

10" 701 w/ , 7" 1110 w/500, D 2235

JUN 27 '56 3880 JUL 3 '56 DST 4120-30or 21" 9 in 2 1/2" spray oil in
11" reversed out FW 250-500

BIT 1240/20" + 537 MCF 6 in 4"

4 1/2 @ 4248/300 JUL 17 '56 CO. 120/

4140-60 F/W 93 Boph. Rng Tbg.

JUL 18 '56 JUL 25 '56 T2R AUG 1 '56 . AUG 8 '56

AUG 15 '56 . AUG 22 '56 . AUG 29 '56 . SEP 5 '56 . SEP 12 '56

FORM 513-1 SUNRAY

SEP 19 '56

SEP 26 '56

OCT 3 '56

Ph. # 401

Bopd no lctw.

21-34-43

Cent. mar