


Section 21 Township 34 Range 43W
Well No. #9 Interstate
Company PEPL

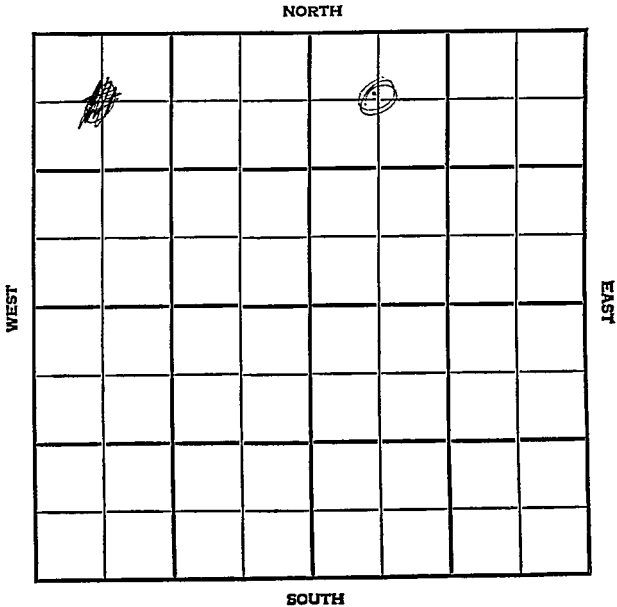

County Morton Elev. _____
 Sec. 21 Twp. 34 Rge. 43W
 Company P E P L
 Farm Name Interstate No. 9

TOPS	DEPTH	LOG	DATUM	Loc. in Sec.
Anh.				6 NW NE
Tr.				
H.				
Tr.				
Dg.				
BL.				
L.				Geol.
K.C.				Contr.
B.K.C.				
Ce.				Nye & Snell Tool
C.				
M.				Pool
M.				Interstate
K.				
Mz.				
Mq.				
V.				
S.				
S.				
A.				
R.				
PE.				
G.				
T.D.				

		0	
		NOV 14 '56	
FIRST REPORT			

Date Co. and 10-31-56

10" @ 101 w/100, 7" @ 1129 w/700, Drlg. 4035

2201 " S 101"

2 2

Co.

County Morton Elev. 3477
 Sec. 21 Twp. 34 Rge. 43W
 Company P E R L
 Farm Name Interstate No. 0-9

TOPS	DEPTH	LOG	DATUM	Loc. in Sec.
Anh. <u>W86</u>		<u>2468</u>		<u>C NW NE</u>
Ip.		<u>2470</u>		
H.				
Tr.				
Dg.				
Bl.				
L. <u>CSO</u>		<u>2909</u>		Geol. _____
M.G. <u>659</u>		<u>3109</u>		Contr. _____
B.K.C.				
Ce. <u>MW</u>		<u>3788</u>		<u>Nye & Snell Tool</u>
C. <u>MW</u>		<u>4098</u>		
M. <u>Purdy</u>		<u>4140</u>		Pool _____
M.				<u>Interstate</u>
K.				
Mz.				
Mq.				
V.				
S.				
S.				
A.				
R.				
PE.				
G.				
T.D. <u>4240</u>				

o

COMPLETE

JAN 23 57

Tool

No.

SAC

T.

R.

Date Comm. spd. 10-31-5610" @ 101 w/100, 7" @ 1129 w/700, Drlg. 4034NOV 21 '56 DST 4143- 4240 or 33"C/30 sec. ga 400 MCF in 15"SPRY oil 129" sec 900' oil + 5'Wt. FR 140-270 BHP 1180/20"4 1/2 @ 4199/125 - 8 3/8 CO 416932/4142-50' F/W 2 1/2 BOPH+ GAS ga 500 MCF FR2C 2x2& 12 BOPH + 100' BOPH + 100' BOPHST P + 20' BOPH + 100' BOPH

JAN 12 57