

DX 78-1

Morton

KANSAS

21


34

43W

Section _____ Township _____ Range _____

Well No. #8 Interstate

Company P E EL

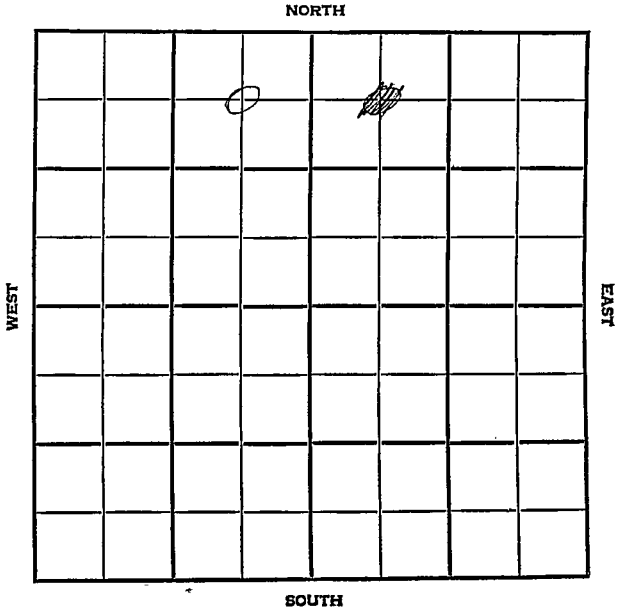

County Morton Elev. 3489DF
 Sec. 21 Twp. 34 Rgs. L3W
 Company P. E. P. I.
 FarmName Interstate No. 8

TOPS	DEPTH	LOG	DATUM
Anh.			
Tp.			
H.			
Tr.			
Dg.			
Bl.			
L.			
K.C.			
B.K.C.			
Ce.			
C.			
M.			
M.			
K.			
Mz.			
Mo.			
V.			
S.			
S.			
A.			
R.			
Pe.			
G.			
T.D.			

Loc. in Sec.

C NE NW

Geol.

Contr.

Pool

FIRST REPORT			
JUL 24 '56			

Date Comm. spd. 10-16-56

10" @ 113 w/100, 7" @ 1116 w/750, Drlg.
 2670

SSW

SSW

Co.

No.

Sec.

T.

R.

Co.

County Morton Elev. 3489DF
 Sec. 21 Twp. 34 Rge. 43W
 Company I.E.F.L.
 FarmName Interstate No. 0-8

TOPS	DEPTH	LOG	DATUM
Anh. <u>FW26</u>	<u>1</u>	<u>2479</u>	
Tp.		<u>2381</u>	
H.			
Tr.			
Dg.			
Bl.			
L. <u>C50</u>		<u>2917</u>	
K. <u>LS9</u>		<u>3116</u>	
B.K.C.			
Ce.		<u>3803</u>	
C. <u>MWSH</u>		<u>4102</u>	
M. <u>" 50</u>		<u>4118-28</u>	
M. <u>Purdy</u>		<u>4151-92</u>	
K.			
Mz.			
Me.			
V.			
S.			
S.			
A.			
R.			
Pe.			
G.			
T.D. <u>4244</u>	4245	<u>4244</u>	

Loc. in Sec.

C NE NW

Geol.

Contr.

Pool

Loc.

COMPLETE		
JAN 23 '57		

No.

Date Comm. spd. 10-16-56

10" @ 113 w/100, 7" @ 1116 w/750, Drlg.

2670' 31.55 RING PIPE NOV 7 '56

5 1/2 @ 4241/200 CO 4212 100

14153-73 Flwd 196 BO 5 hrs

NOV 13 '56 NOV 21 '56 ✓ NOV 28 '56 ✓ DEC 5 '56 DEC 12 '56

DEC 19 '56 DEC 6 '56 ✓ JAN 2 '57

JAN 23 '57 ST P. 245 Bopd

no/wtr

Sec.

T.

R.