DX 78-1

Morton **KANSAS**

Section 21 Township 34 Range 43W

Well No. #1-21 Interstate

Company Panhandle Eastern

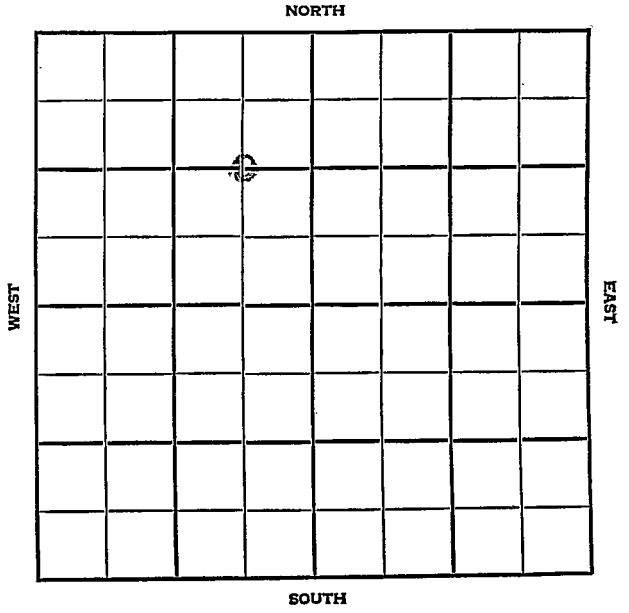

Morton

SEC.	TWP.	R. KANSAS
21	34	43W

WELL NO.
1-21 Interstate

FARM

COMPANY
Panhandle Eastern

CONTRACTOR

Interstate

1400' Ft. from N. Line

Ft. from S. Line

Ft. from E. Line

2000' Ft. from W. Line

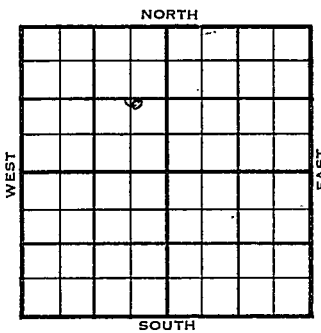

E½ NW¼

1955	ELEVATION	REPORT
5/26		Comm 5-11-55 10" @ 604 w/350
6/22		Comm 5-11-55 Waub 2470 TP 2670 L 2904 10" @ 604/350 7" @ 2981-300 CO 36/2940-49 32/2915-21 1000A 927 mcfg SP 2860 20/2845-50 SSG 36/2804-13 32/2780-88 1000 A 3 mcfg 4000 A 4,480 mcfg 20 gwph SP 2750 20/2740-45 16/2717-21 20/2707-12 20/2691-96 656 mcfg 1000 A 7,643 mcfg 4000 A 13,774 mcfg 6000 A Comp 26,512 mcfgpd 416#

COMPLETED

DX-78

Twp. Pool

Co. Facet

FORM 513 REV. SUNRAY

FIRST REPORT

County Morton Elev.

Sec. 21 Twp. 34 Rge. 43W

Company Panhandle Eastern

Farm Name Interstate No. 1-21

TOPS	DEPTH	LOG	DATUM
Anh.			
Tp.			
H.			
Tr.			
Dg.			
Bl.			
L.			
K.C.			
B.K.C.			
Ce.			
C.			
M.			
M.			
K.			
Mz.			
Mo.			
V.			
S.			
S.			
A			
R.			
P€.			
G.			
T.D.			

Loc. in Sec. E½ NW¼

1400' NL

2000' WL

Geol.

Contr.

Pool Interstate

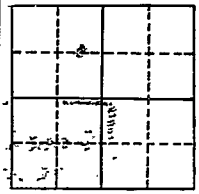

Date Comm. 5-11-55

10" @ 604 w/ 350

Co.

Lse.

No.

Sec.

T.

R.

FORM 513 REV. SUNRAY

County Morton Elev.

Sec. 21 Twp. 34 Rge. 43W

Company Panhandle Eastern

Farm Name Interstate No. 1

TOPS	DEPTH	LOG	DATUM
Anh. Wau b	2470		
T.P.	2670		
H.			
Tr.			
Dg.			
Bl.			
L.	2904		
K.C.			
B.K.C.			
Ce.			
C.			
M.			
M.			
K.			
Mz.			
Mo.			
V.			
S.			
S.			
A			
R.			
P€.			
G.			
T.D.	2990		

Loc. in Sec. E½ NW¼ 1400' NL 2000' WL

Geol.

Contr.

Pool Interstate

COMPLETE

JUN 22 19 55

Date Comm. 5-11-55

10" @ 604/350 7" @ 2981-300 CO

36/ 2940-49 32/ 2915-21 1000 A

927 mcfg SP 2860 20/ 2845-50 SSG

36/ 2804-13 32/ 2780-88 1000 A

3 mcfg 4000 A 4,480 mcfg 20 gwph

SP 2750 20/ 2740-45 16/ 2717-21

20/ 2707-12 20/ 2691-96 656 mcfg

1000 A 7,643 mcfg 4000 A 13,774 mcfg

6000 A Comp. 26,512 mcfgpd 416#

Co. Lse. No. Sec. T. R.