

DX 78-1


Morton

KANSAS

Section 21 Township 34 Range 12W

Well No. #1 Kansas

Company Panhandle Eastern

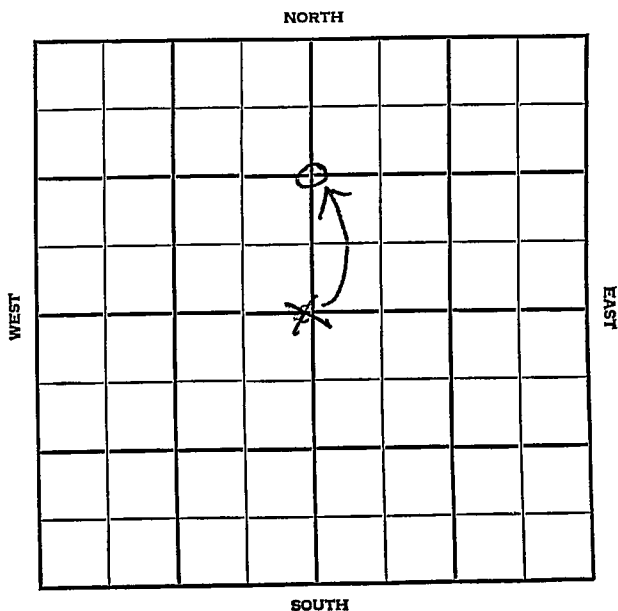

Morton

KANSAS

SEC.	TWP.	R.
21	34	42W

WELL NO.

1 Kansas

FARM

COMPANY

Panhandle Eastern

CONTRACTOR

Greenwood Pool


2640' / 320 Ft. from N. Line

Ft. from S. Line

2640' Ft. from E. Line

Ft. from W. Line

C 1/2 Sec

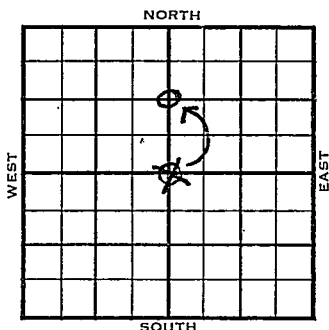

	ELEVATION	REPORT
1955	3491	
6/1	Spud 5-29-55 Drlg 650	
7/13	10 3/4" @589/350 5 1/2 @3075-300 CO perf 3004-44 2993-99 2983-88 2965-75 1000A 3,448 mcfg 4000A CO 8,366 mcfg SP 2900 perf 2887/93 2865-76 2852-59, 2841-47, 2827-34 2000A 8,702 mcfg 7000 A CO to TD Comp. 24,404# Tops: Log Datum Anh.Waub. 2610 Tp. 2820 L. 3048 4443 TD 3077	

COMPLETED

County Morton State KansasSec. 21 (Blk. Twp.) 34 (Sur. Rge.) 42W Map No.Operator Panhandle EasternWell No. 1 Farm KansasElev. Location C Sec.

2640Ft. From N Line Sec.2640Ft. From E Line Quarter1st. Report JUN 1 1955

Completion

Remarks

Spudding Date. 5-29-55Drlg. Data Greenwood Pooldrlg. 650K-34

JUN 10 1955

Scott Cards *mmc*

Land Small Map

Land Wall Map

Tracings

France Map

Pierce Map

Misc.

SCOUT TICKET

DX-201

Kansas

SEC.

TWP.

R.

21

34

42W

WELL NO.

1 Kansas

FARM

COMPANY

Panhandle Eastern

CONTRACTOR

CORRECTION

C N $\frac{1}{2}$ Sec.

1320 FT. FROM N. LINE


FT. FROM S. LINE

2640 FT. FORM E. LINE

FT. FROM W. LINE

K-34

Morton County

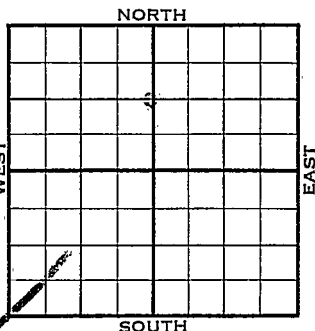☐

LOCATION

☐

RIG UP

DRILLING AND REMARKS:

Reported

C Sec.

RECORD

CASED IN., FT.

SAND

GAS

OIL

TOTAL DEPTH

1ST 24 HRS. NAT.

1ST 24 HRS. AFTER SHOT

GAS

CU. FT.

DRY HOLE

ABANDONED

PRODUCTION

DATE

JUN 15 1955

SCOUT

L. J. Harris


CORRECTION

Scout Cards	<i>mm</i>
Land Small Map	
Land Wall Map	
Tracings	
France Map	
Pierce Map	
Misc.	

JUN 16 1955

PC 2141

County Morton Elev. 3491
 Sec. 21 Twp. 34 Rge. 42W
 Company Panhandle Eastern
 Farm Name Kansas No. 1

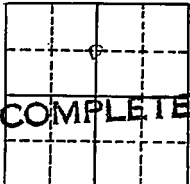TOPS	DEPTH	LOG	DATUM	Loc. in Sec.
Anh. <u>Waub</u>		<u>2610</u>		C N $\frac{1}{2}$ Sec.
Tr.		<u>2820</u>		
H.				
Tr.				
Dg.				
BL.				
L.		<u>3048</u>	<u>+443</u>	Geol.
K.C.				Contr.
B.K.C.				
Ce.				
C.				
M.				
M.				Pool
K.				<u>Greenwood</u>
Mz.				
Mo.				
V.				
S.				
S.				
A.				
R.				
PE.				
G.				
TD.	<u>3077</u>			

Date Comm. 5-29-55 **JUL 13 1955**

10 3/4" @ 589/350 5 1/2" @ 3075-300

CO perf. 3004-14 2993-99 2983-88

2965-75 1000 A 3,418 mcf/g 4000 A

CO 8,366 mcf/g SP 2900 perf/ 2887-93

2865-76 2852-59 2841-47 2827-34

2000 A 8,702 mcf/g 7000 A CO to TD

Comp. 24,404 mcf/gpd 420#

JUL 25 1955

Scout Cards	JC
Land Small Map	
Land Wall Map	
Tracings	
France Map	
Pierce Map	
Misc.	