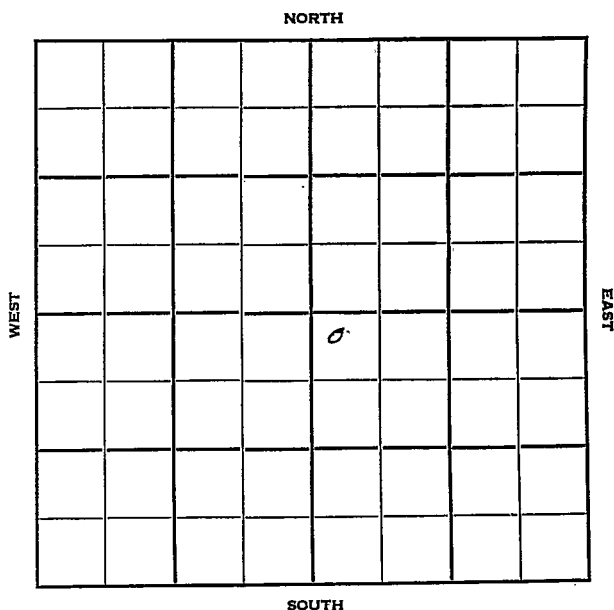


Section 21 Township 34 Range 40WWell No. #1 Wiker "A"Company Cities Service

Sec. 21 Twp. 34 R. 40W

Well No. #1 Wiker "A" Farm

Cities Service Company

Hugoton Pool Contractor


225' Ft. from N. Line

 Ft. from S. Line

 Ft. from E. Line

225' Ft. from W. Line

NW NW SE

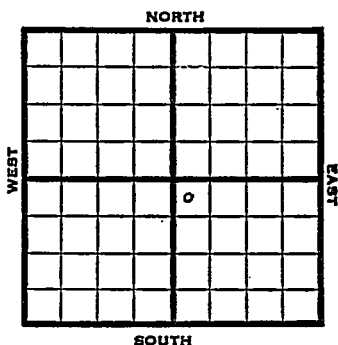

1951 Elev. 3376' REPORT

4/25 Location

6/13 Spud 4-27-51
Gas Well TD 2665
8" @ 417 5" @ 2664 TD 2665
Her. 2445 Kri 2480 Win. 2540
Ft. Riley 2610 CO to 2645
80/2610-26 50/2480-90
130/2496-2522 160/2540-72
17,500 A Comp. 15,800,000 gas 403#

COMPLETED

County: Morton State: Kansas

Sec: **21** (Blk. Twp.) **34** (Sur. Rge.) **40W** Map No.

Operator Cities Service

Well No. 1 Farm Wiker Bad

Elev.	Location	NW	NW	SE
-------	----------	----	----	----

FIRST REPORT

225 Ft. From **N** Line: **SE**

225 Ft. From V Line Quarter.

1st. Report APR 25 1951

Completion


Remarks

Spudding Date _____

Drig. Data. Hugoton Pool

Location _____

J. E. TYRA

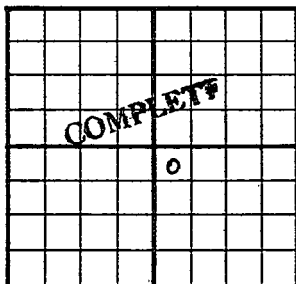County Morton State KansasSec. 21 (^{Blk.}_{Twp.}) 34 (^{Sur.}_{Rge.}) 40W Map No.Operator Cities ServiceWell No. 1 Farm Wiker "A"Elev. 3376 Location NW NW SE225 Ft. From N Line SE225 Ft. From W Line Quarter

1st. Report

Completion JUN 13 1951Remarks Hugoton PoolSpudding Date 4-27-51Drlg. Data Gas well TD 26658" @ 417 5" @ 2664 TD 2665Her. 2445 Kri. 2480 Win. 2540Ft. Riley 2610 CO to 264580/ 2610-26 50/ 2480-90130/ 2496-2522 160/ 2540-7217500 A Comp. 15,800,000 gas 403#

J. E. TYRA