

Morton

KANSAS

21

34


43W

SECTION _____ TOWNSHIP _____ RANGE _____

WELL NO. #11 Interstate

COMPANY PEPL

NORTH

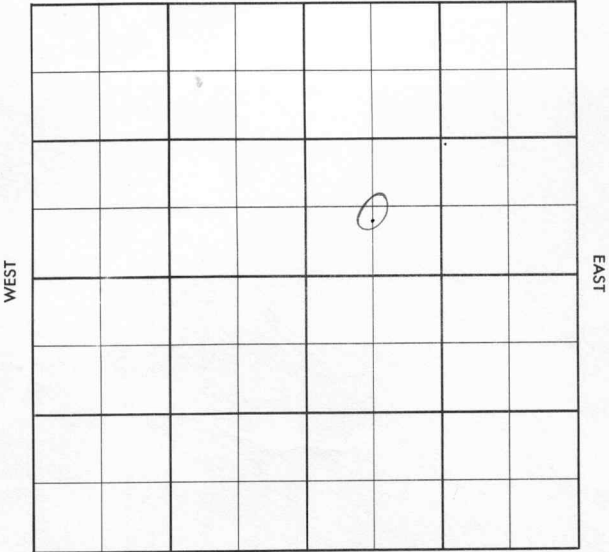

SOUTH

County Morton

Elev. _____

Sec. 21Twp. 34Rge. 43WCompany PEPLFarm Name XXXX InterstateNo. 11

TOPS

DEPTH

LOG

DATUM

Loc. in Sec. _____

Anh. _____

Tp. _____

H. _____

Tr. _____

Dg. _____

BL. _____

L. _____

K.C. _____

B.K.C. _____

Ce. _____

C. _____

M. _____

M. _____

K. _____

Mz. _____

Mq. _____

V. _____

S. _____

S. _____

A. _____

R. _____

Pe. _____

G. _____

T.D. _____

C SW NE


Geol. _____

Contr. _____

Nye & Snell Tode

Pool

Interstate

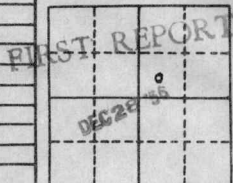Date Comm. 12-19-5610" @ 99 w/100, 7" @ 1134 w/750, WOC34

Co.

County Morton Elev. 3465
 Sec. 21 Twp. 34 Rgs. 43W
 Company PEPL
 Farm Name XXXX Interstate No. 0-11

TOPS	DEPTH	LOG	DATUM	Loc. in Sec.
Anh.				
TP. <u>W26</u>		<u>2459</u>		<u>C SW NE</u>
H. <u>TP</u>		<u>2659</u>		
Tr.				
Dg.				
BL.				
L. <u>C50</u>		<u>2901</u>		Geol.
K.E. <u>659</u>		<u>3104</u>		Contr.
B.K.C.				
Ce.		<u>3796</u>		
C.				<u>Nye & Snell Tools</u>
M. <u>Mursh</u>		<u>4103</u>		Pool
M. <u>Purdy</u>		<u>4148</u>		Interstate
K. <u>Dase purdy rd</u>		<u>4156</u>		
Mz.				
Mq.				
V.				
S.				
S.				
A.				
R.				
PE.				
G.				
T.D.	<u>4260</u>			

JAN 23 '57
 0
 ABANDONED

Lse

No.

Sec.

T.

R.

Date Comm. 12-19-56

10" @ 99 w/100, 7" @ 1134 w/750, WCC JAN 2 '57

11/3/00 JAN 9 '57 4 1/2 4215/200

JAN 16 '57 CO 4178- 8/4154-56 & 8 1/2

Bswph Broke down JAN 23 '57

Temp abd o