


Sumner

KANSAS

SECTION 22 TOWNSHIP 34 RANGE 3WWELL NO. #2 SuberaCOMPANY Herndon Drlg.

NORTH

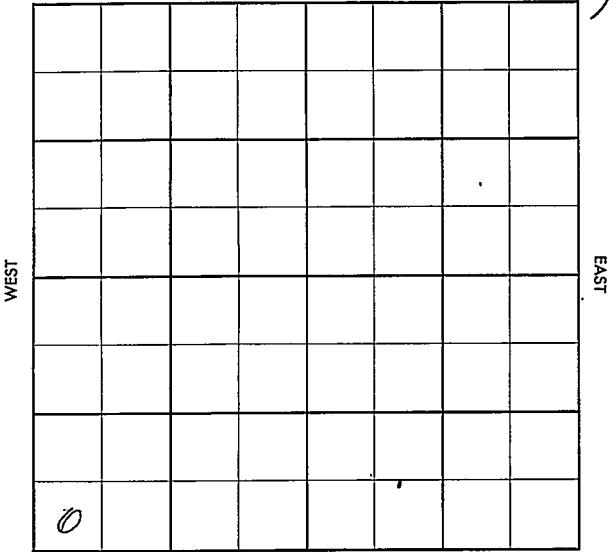

SOUTH

Summer

KANSAS

SEC.	TWP.	R.
22	34	3 W

WELL NO. # 2 Subera FARM

COMPANY Herndon Drlg.


CONTRACTOR Co. tools Wildcat

_____ FT. FROM N. LINE

_____ FT. FROM S. LINE

_____ FT. FROM E. LINE

_____ FT. FROM W. LINE

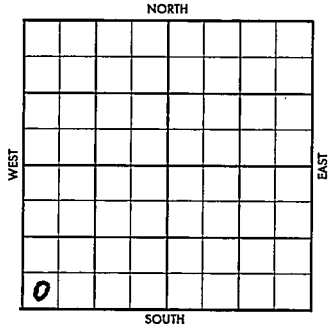

SW SW SW

SDX - 1/2 Mile

ELEVATION	REPORT
1957	

1/16	Location

County Sunmer Elev. 1191
 Sec. 22 Twp. 34 Rge. 3W
 Company Herndon Drilling
 Farm Name Subera No. 2

	DEPTH	LOG	DATUM	Loc. in Sec.
				SW SW SW
H. <u>3444</u>	<u>3444</u>			SE 21
T. <u>3447</u>	<u>3446</u>	<u>3551</u>		SW 22
Dg.				SW 23
BL.				
L.				Geol. <u>Kathol</u>
K.C.	<u>3628</u>	<u>3638</u>		<u>NA 21</u>
B.K.C.				Contr.
Ce.				Co. tools
C.				<u>Subera</u>
M.		<u>4309</u>	<u>3118</u>	Pool
M.		<u>4716</u>		Wildcat
K.				
Mz.				
Mo.				
V.		<u>4721</u>	<u>3520</u>	
S.		<u>4732</u>	<u>3507</u>	COMPLETE
S.				<u>1/2 mile</u>
A.				
R.				
PE.				
G.				
T.D.	<u>4744</u>			0 MAR 13 '57

Date Comm.

Location JAN 23 '57 MIR JAN 30 '57 1-23-57 85/8 653/475 M 3630FEB 8 '57 X upper hole tops still 3168Log 3536 pipe stuck @ 4570FEB 13 '57 X FEB 20 '57 X LogTops DST 4309-25 or 1 hr 8 1/2 "rec. 220' SOEGCM + TR. WTR. BHP? Mz 4716 VIO 4721 DST 471827 or 1 hr rec. 20' Md BHP 0

~~WILDCAT~~

County Sumner Elev. _____
 Sec. 22 Twp. 34 Rge. 3W
 Company Horndon Drig.
 Farm Name Subers No. 2

TOPS	DEPTH	LOG	DATUM	Loc. in Sec.
Anh.				SW SW SW
TP.				
H.				
Tr.				
Dg.				
BL.				
L.				Geol. _____
K.C.				Contr. _____
B.K.C.				Co. tools _____
Ce.				Pool _____
C.				Wildcat _____
M.				
M.				
K.				
Mz.				
Mo.				
V.				
S.				
S.				
A.				
R.				
Pe.				
G.				
TD.				

FIRST REPORT	
1/2 mile	
JAN 16 '57	

Date Comm. _____

Location _____

28

FEB 1 1957

FEB 1 1957

SP 4738 DST 4727-44 1hr
 2 1/15" ga 69 MCF rec 180' oil
 + 95' O&GCM FP 30-125 DHP
 1695 RTD 4744 5 1/2 @ 4740
 MICT CO FRACT 5" CO 4744 \$ 5
 Boph + Tr. wtr 2nd end of 3rd hr
 decreased to 2 B + Tr wtr DD 4751 1/2
 \$ 1 to 1 1/2 Boph + Tr. wtr PB
 4744 1/2 cal seal Frac \$.25 Boph
 not w 8 hrs prep to run + 69.
 NAT 5 57 P. 190 Bopd + 30
 Bwpd. 13 57 pp 138 B + 37% w.